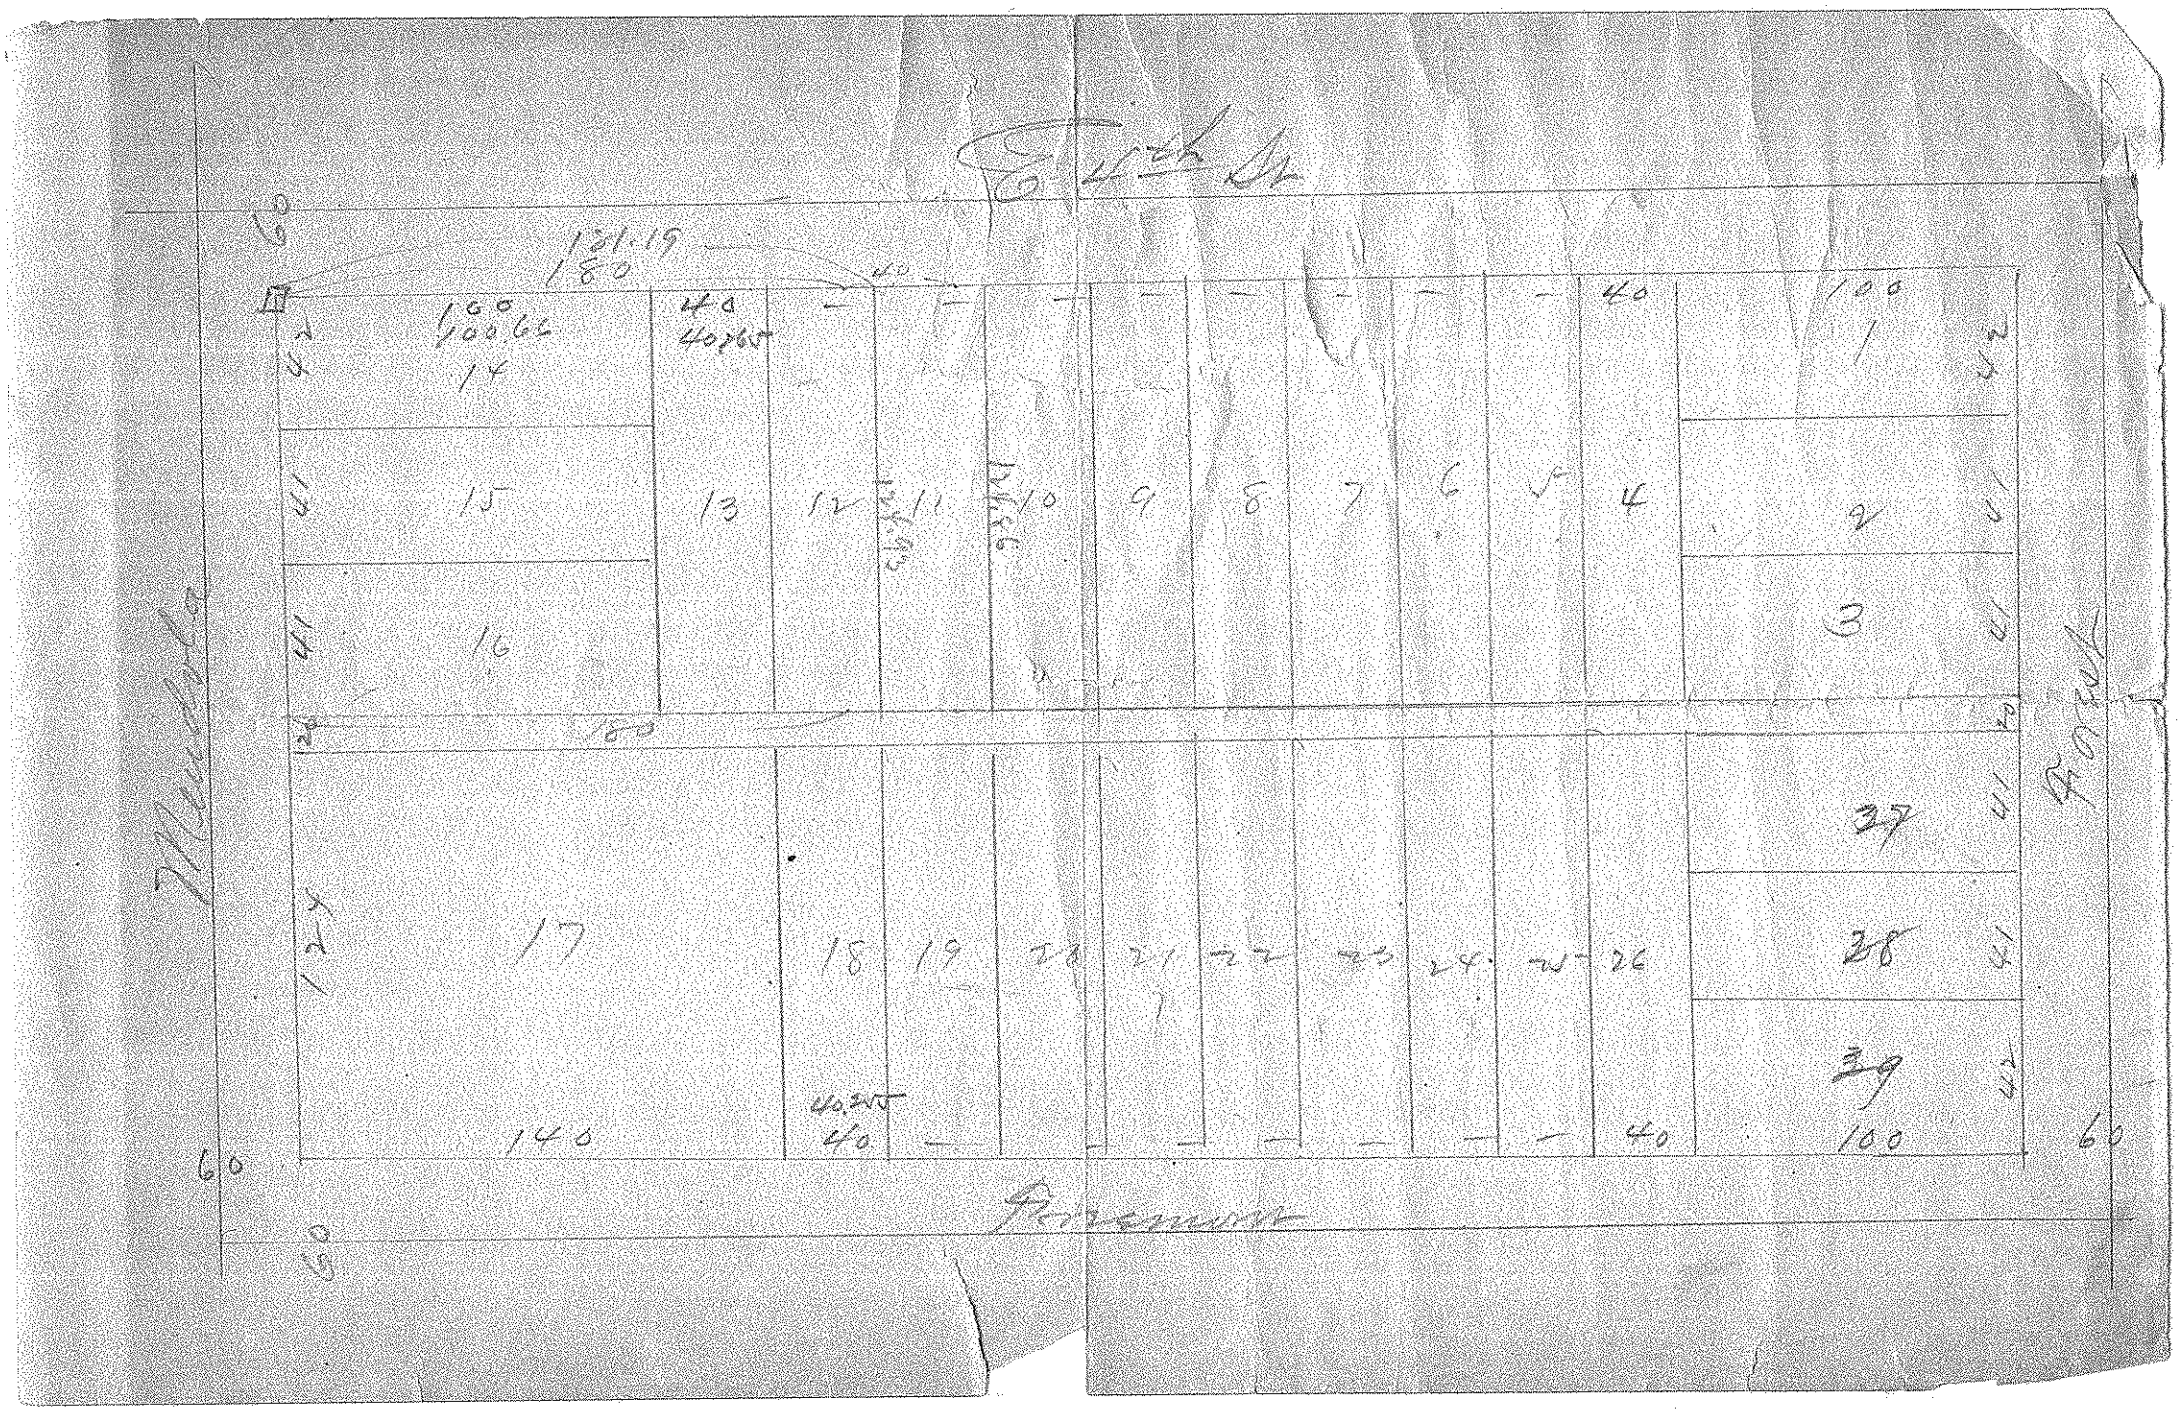
121.19
180
40
100
60
60
60
60
40
40
40