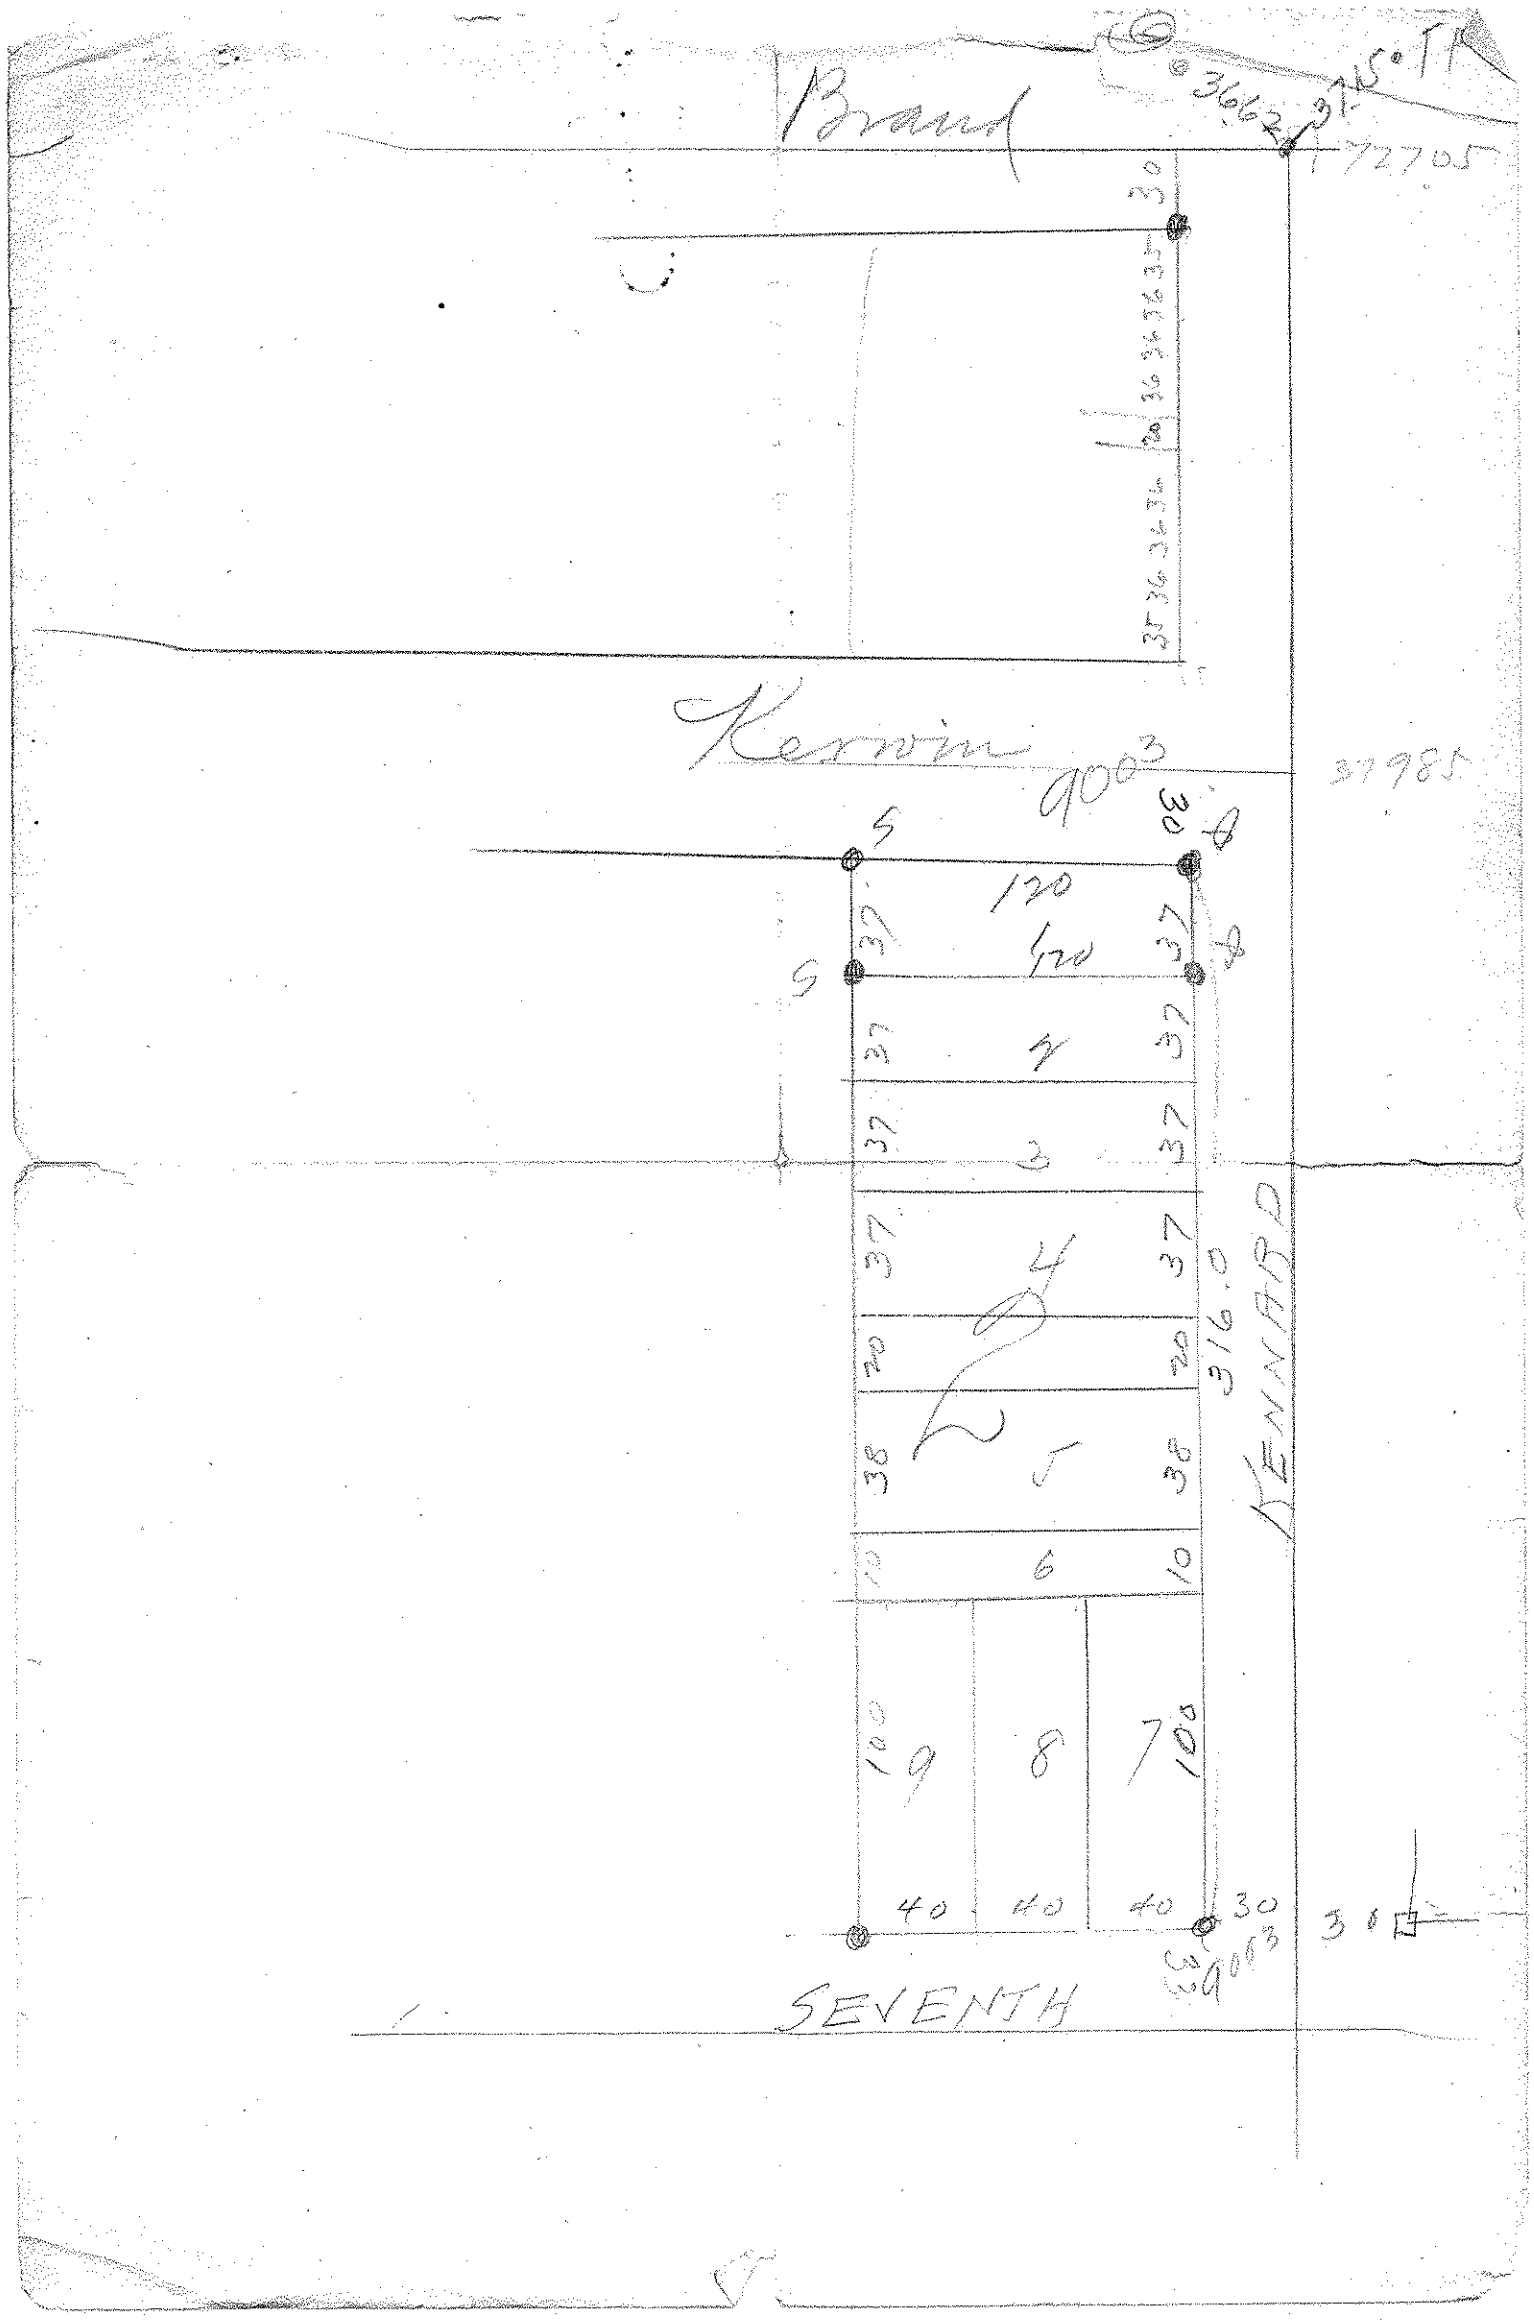
Brand
Kerwin
9003
37985
72705
316.0
SEVENTH
120
40
40
40
30
30
10
10
10