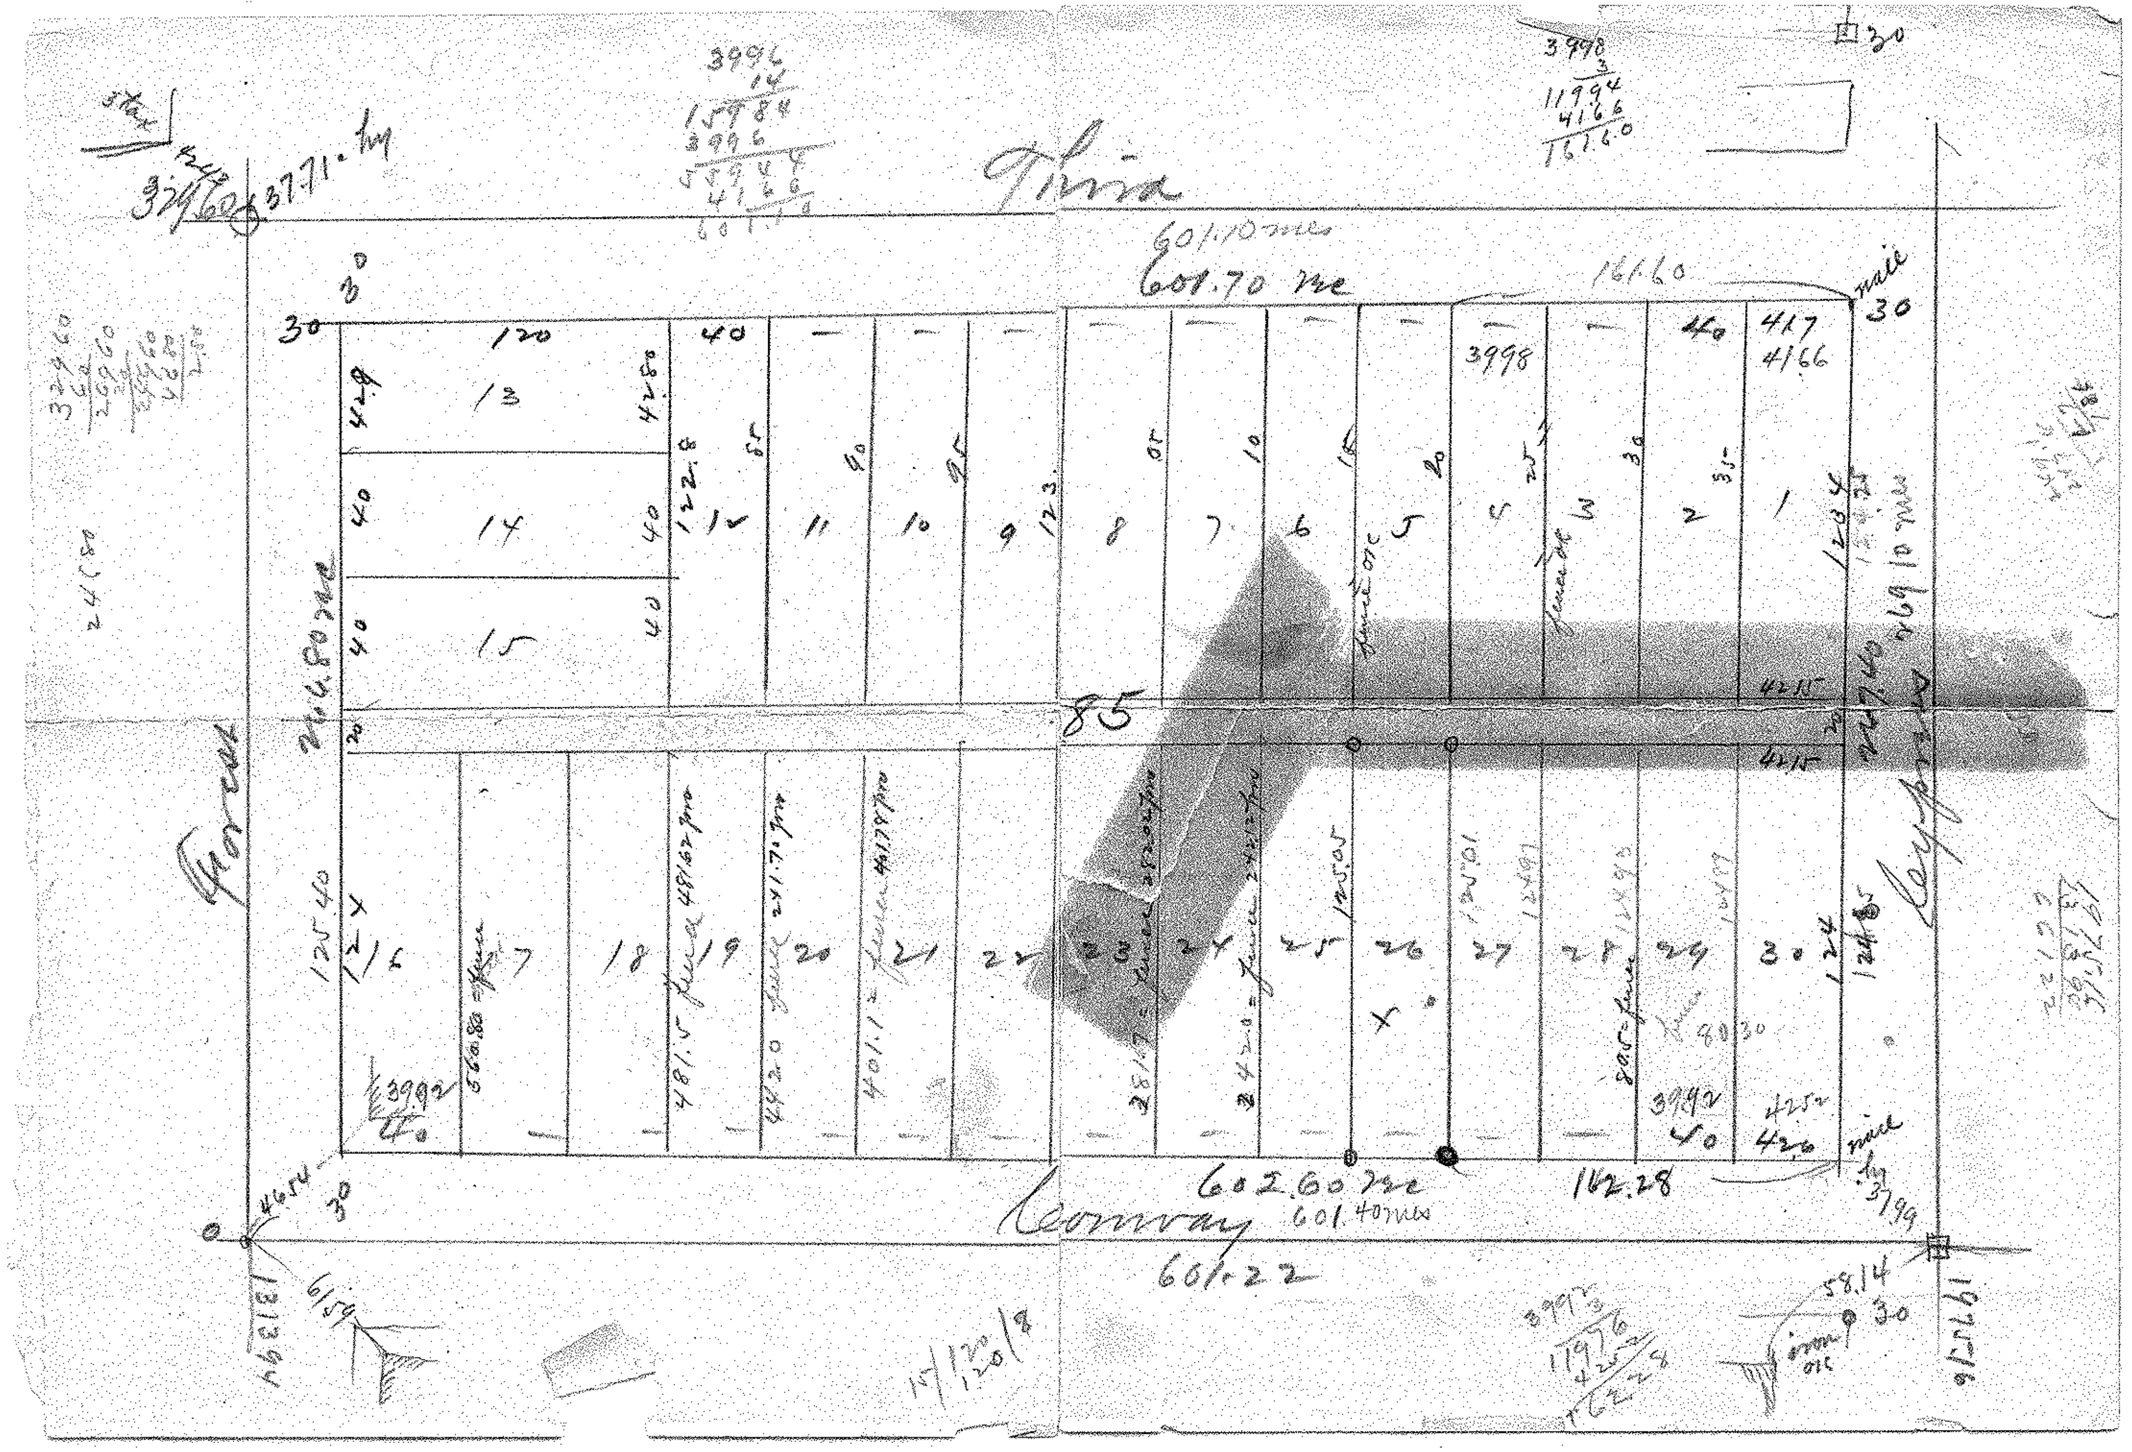
Conway
601.22
601.70 me
601.10 me
602.60 me
601.40 me
162.28
161.60
85
1 2 3 4 5 6 7 8 9 10 11 12 13 14 15
16 17 18 19 20 21 22 23 24 25 26 27 28 29 30
3998
3996
3992
58.14
13139
19776