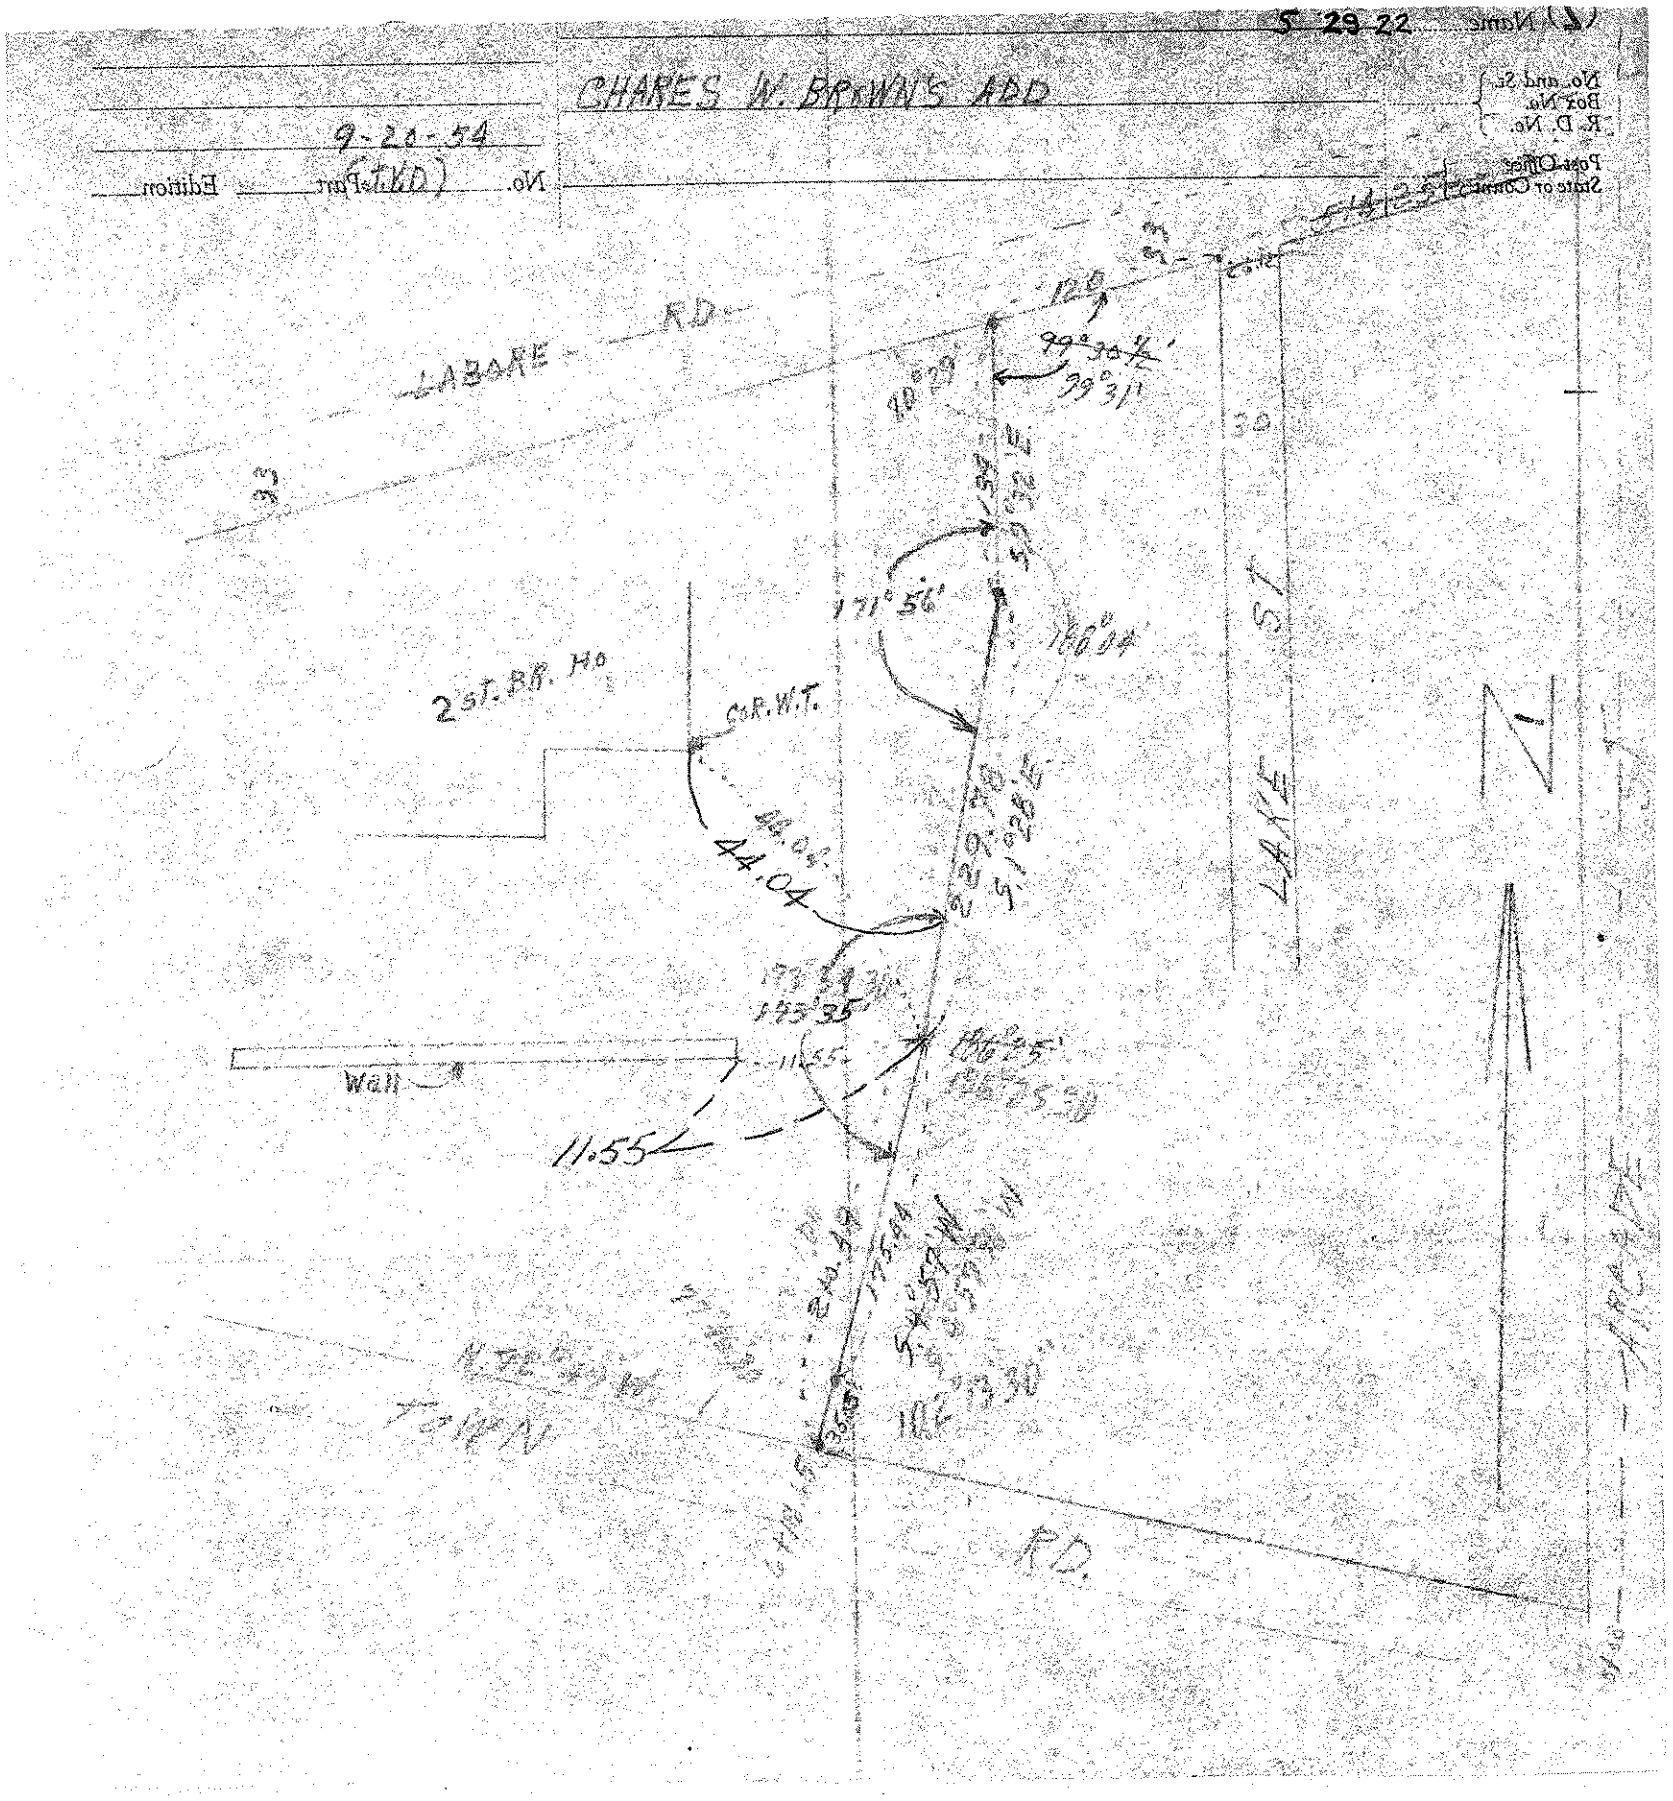

5 29 22
CHARES W. BROWN'S ADD
9-20-54
(T.K.D.)
LABORE RD
2 ST. BR. HO
COR. W.T.
44.04
171° 56'
186° 04'
99° 30½'
99° 31'
11.55
Wall
LAKE ST
TOWN
RD.