5 29 22

2

TELEPHONE 776-0640

PLAT OF SURVEY

OF PROPERTY OF Gerald Facklam

DESCRIBED AS FOLLOWS That part of the West 79.2' of Lot 13, Auditor's Subdivision No. 43, lying South of the North 2168.68' thereof. Reserving an easement for driveway purposes over the East 9' thereof in favor of the West 79.2' of the South 854.14' of the North 2168.68' of said Lot 13.

No. 777 Labore Road, Ramsey County, Minn.

SCALE: 1 INCH = 100 FEET

T. J. WELCH, REGISTERED SURVEYOR
701 EAST 3RD STREET, ST. PAUL, MINN. 55106

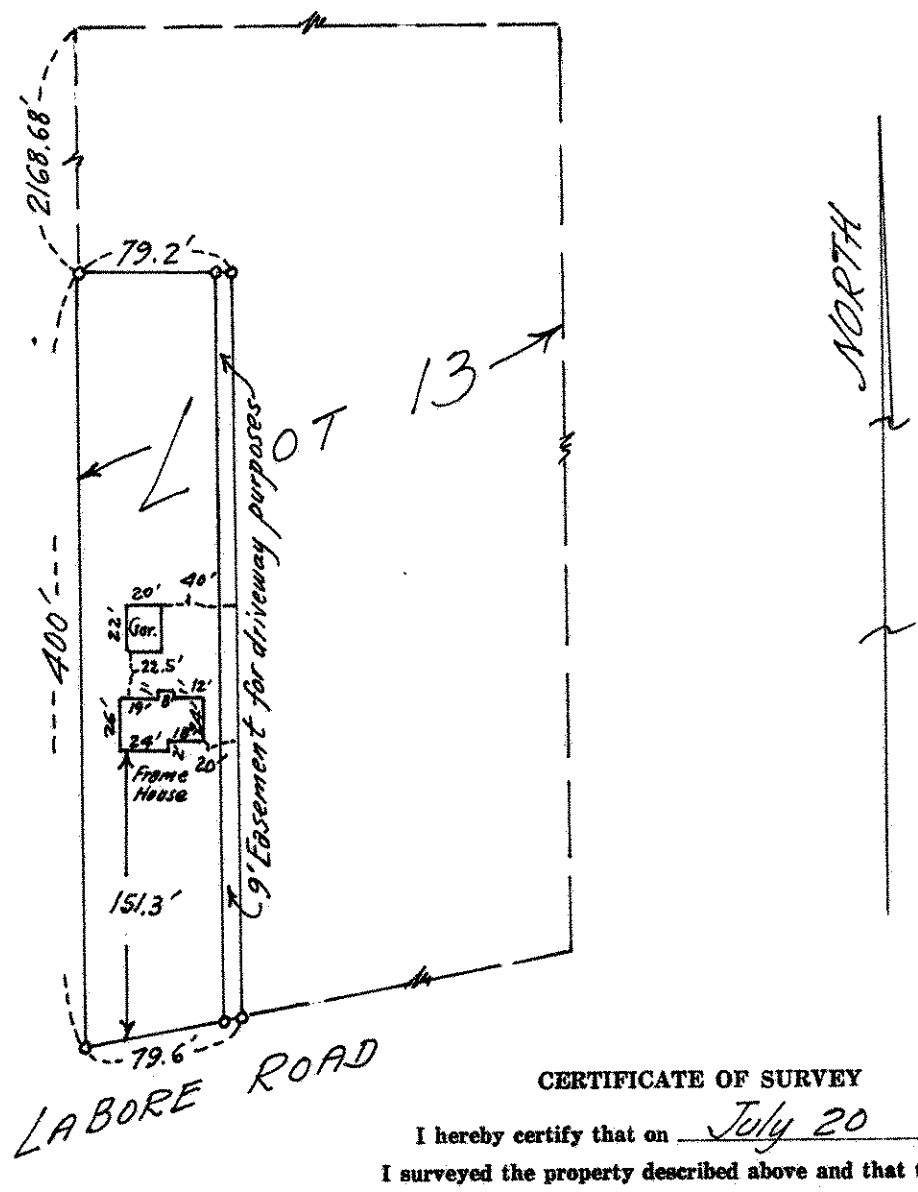

CERTIFICATE OF SURVEY

I hereby certify that on July 20, 1968 I surveyed the property described above and that the above plat is a correct representation of said survey.

T. J. Welch

335/2