

Appl. 49519

TELEPHONE 776-0640


PLAT OF SURVEY

OF PROPERTY OF George W. Merritt

DESCRIBED AS FOLLOWS The South 86 feet of the North 366 feet of Lot 13, Auditor's Subdivision No. 43
No. 3091 Arcade Street, Ramsey County, Minnesota.

SCALE: 1 INCH = 100 FEET

T. J. WELCH, REGISTERED SURVEYOR
701 EAST 3RD STREET, ST. PAUL, MINN. 55106

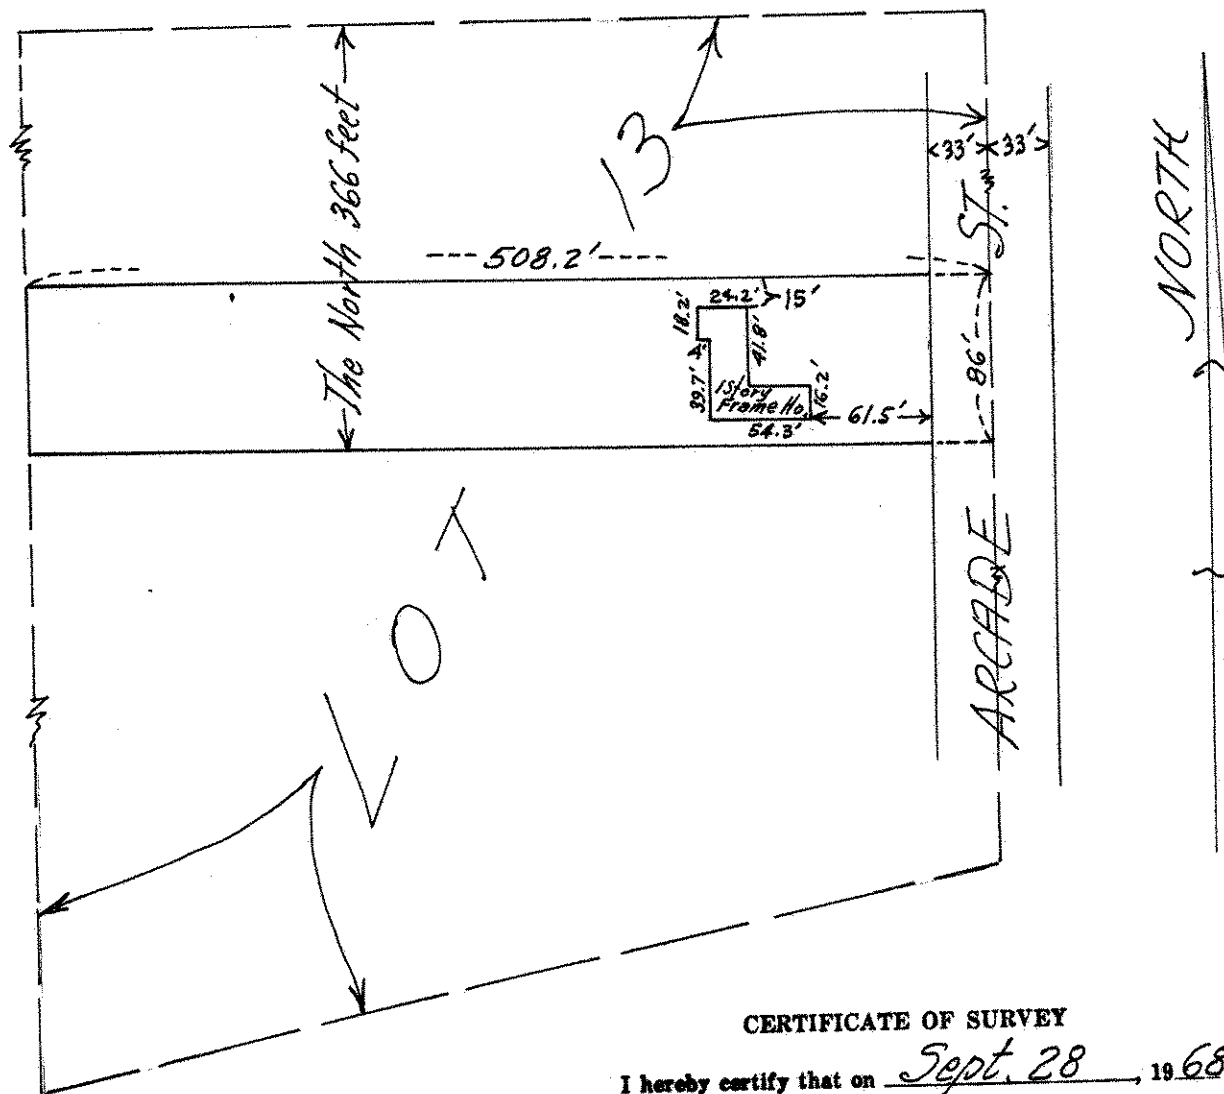

CERTIFICATE OF SURVEY

I hereby certify that on Sept. 28, 1968
I surveyed the property described above and that the above
plat is a correct representation of said survey.

T. J. Welch

This Survey is made exclusively for First Federal
Savings & Loan Assn. of St. Paul.
Lot lines are not guaranteed as this is Survey
for mortgage purposes only.