NE 5 29 22

Certificate of Survey

From the office of

GEORGI- SCHMIDT & ASSOC. INC.

3092 No. Lexington Ave., Roseville, Mn. 55113

LAND SURVEYING

483-4408

I Hereby Certify that this plat shows a survey made by me of the property described on this plat, and that the corners are correctly placed as shown, that this survey, plan or report was prepared by me, or under my direct supervision; and that I am a duly registered Land Surveyor under the Laws of the State of Minnesota.

3684

Job Number: 3684

Surveyed For Richard Palmer

Date 8/18/88

Scale 1"= 40'

By _____
REGISTERED LAND SURVEYOR
Mn. Registration No. 10459

DESCRIPTION:

That part of the East 82.07 feet of the West 202.07 feet of Lot 19, Auditior's Subdivision No. 43 lying North of a line running East at right angles from a point on the East line of the West 120 feet of said Lot 19 and a distance 180 feet feet South thereon from the South line of LaBore Road.

Ramsey County, Minnesota
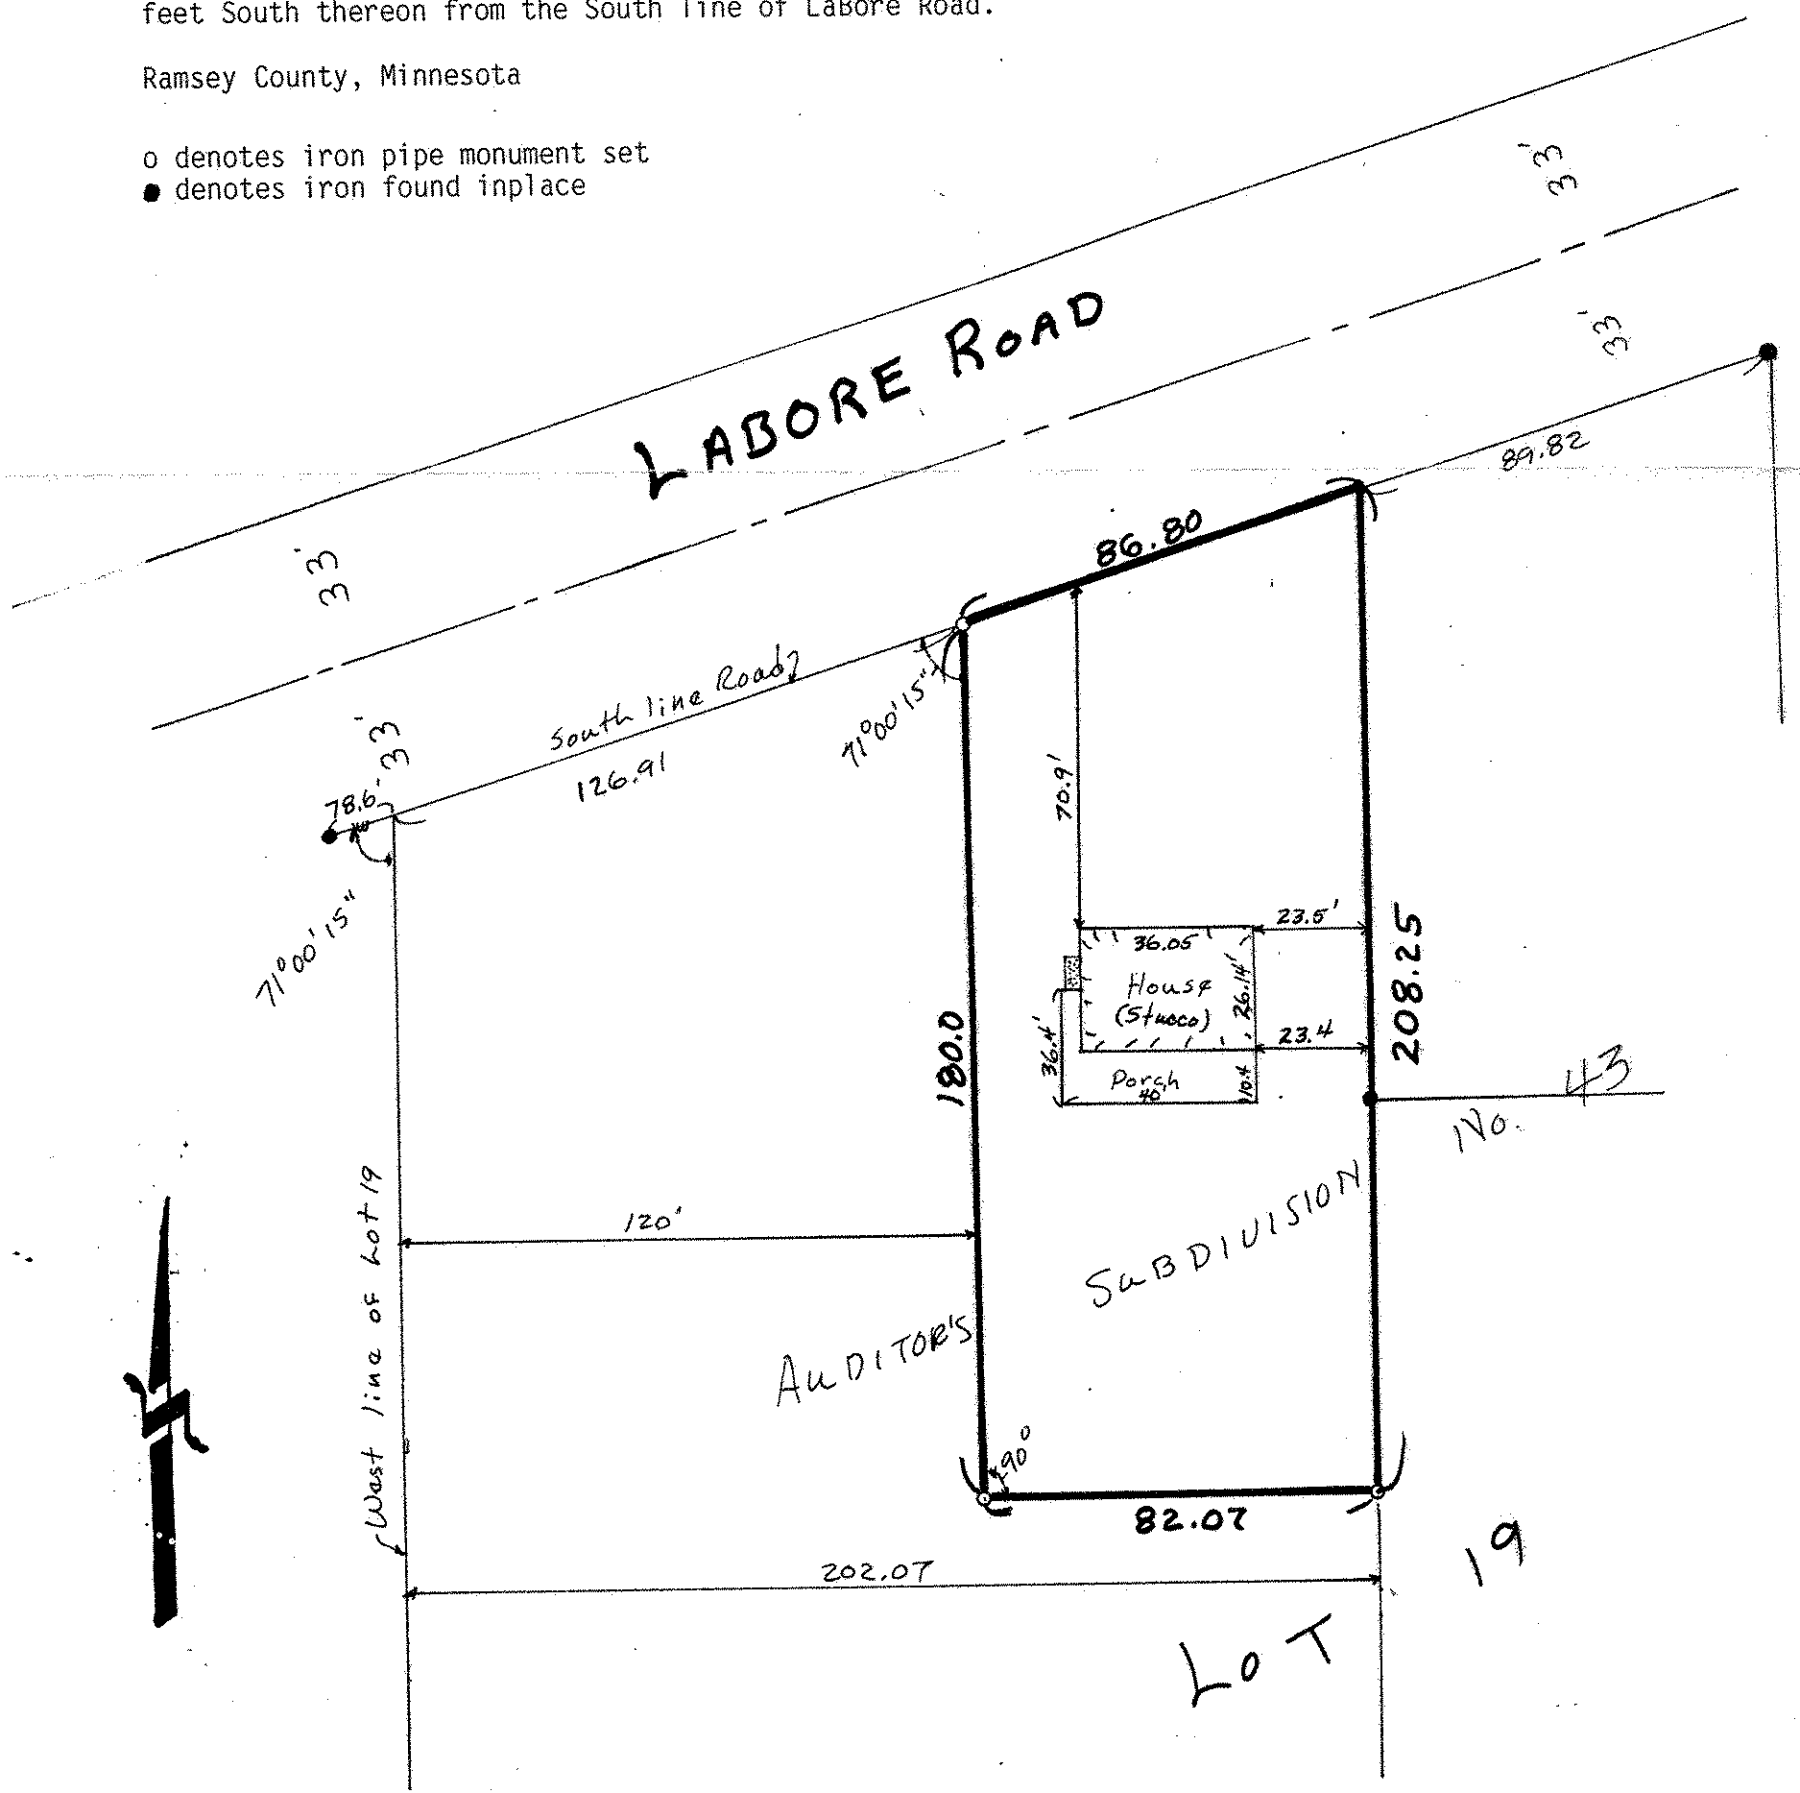
o denotes iron pipe monument set
● denotes iron found inplace