NW 29 29 22

FROM THE OFFICE OF

# CHARLES O. GEORGI COMPANY

2215 West County Road B  Saint Paul, Minnesota 55113

REGISTERED CIVIL ENGINEER AND LAND SURVEYOR

# Certificate of Survey

*I Hereby Certify that* this plat shows a lot survey made by me on the property described on this plat, and that all locations, have been correctly shown, and that the corners are correctly placed as shown

*Date* May, 1971

*Scale* 1" = 30'

By Charles O. Georgi
REGISTERED LAND SURVEYOR

Neil Anderson
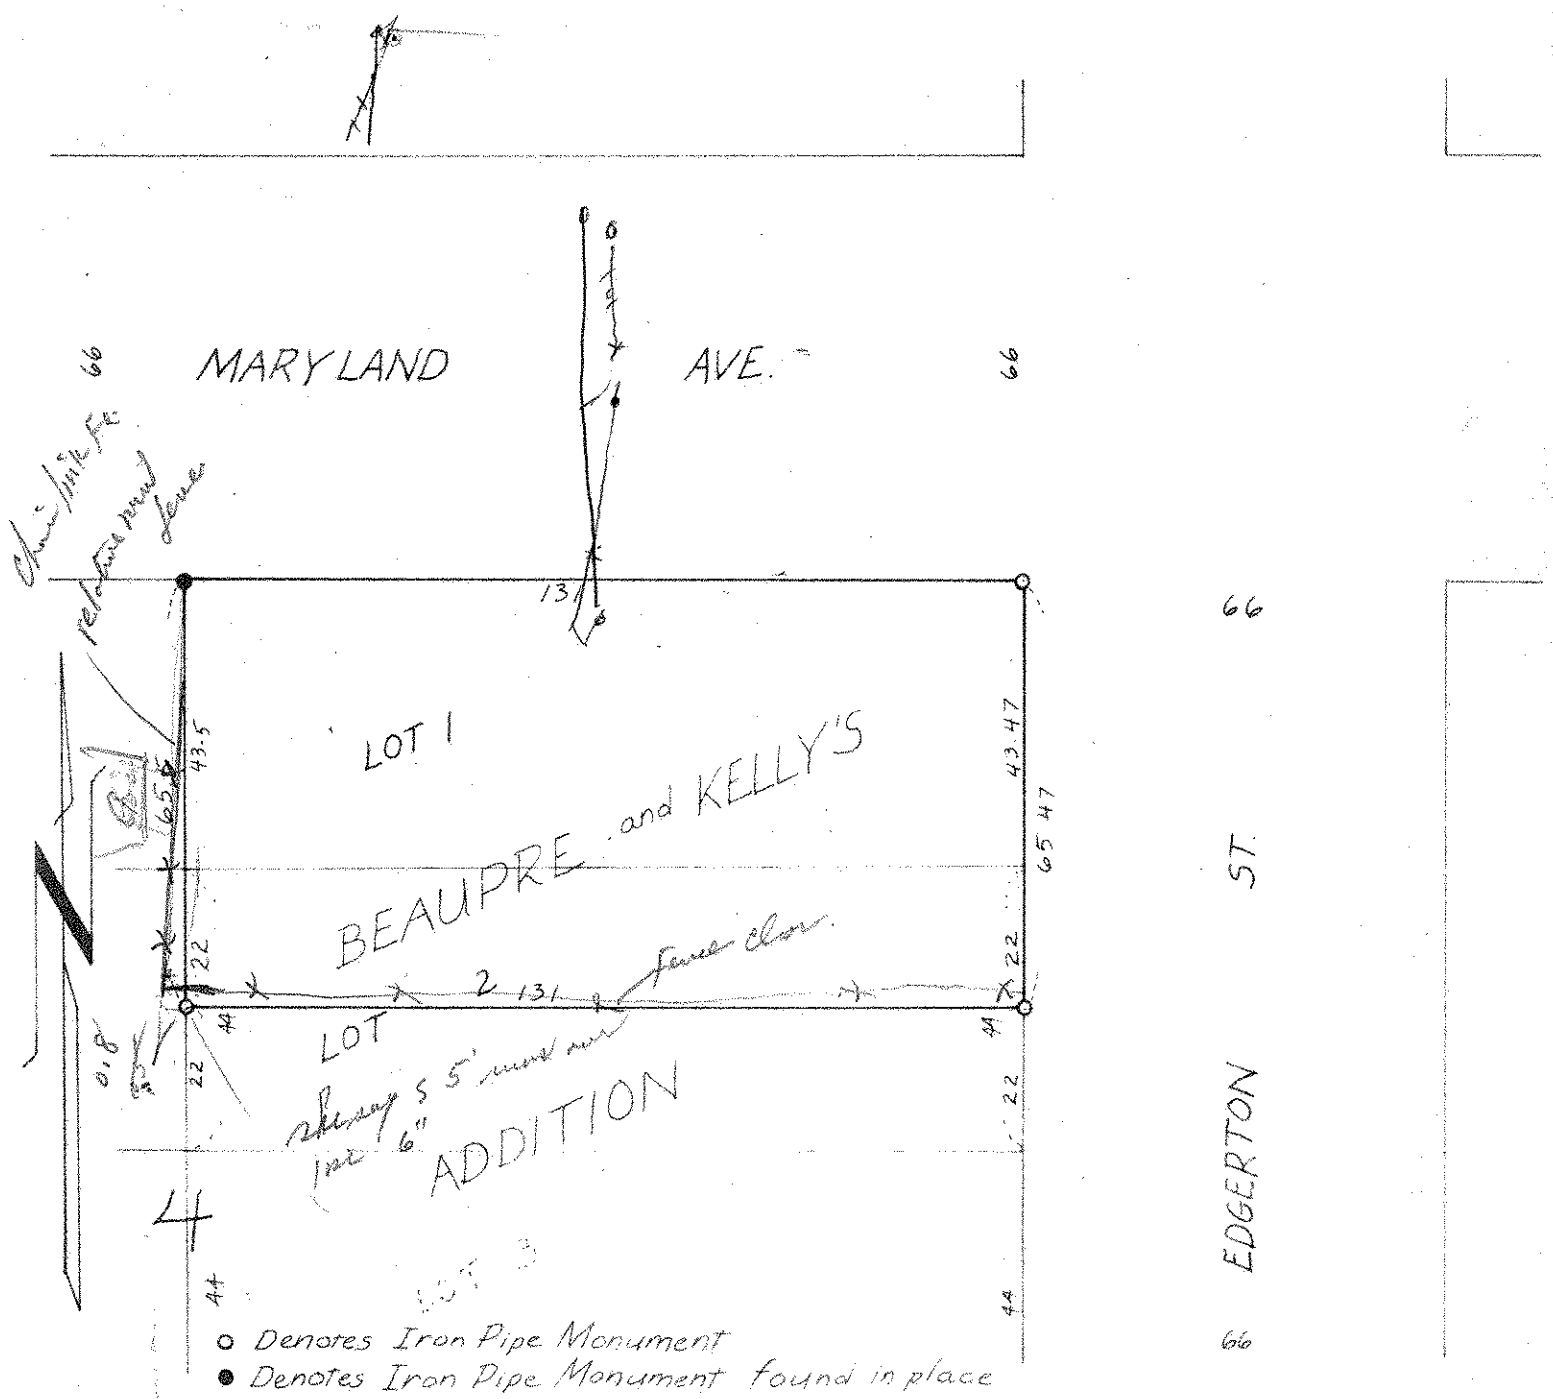
*Description:*
Lot 1 and the North ½ of lot 2, Block 4, Beaupre and Kelly's Addition, Ramsey County, Minnesota.