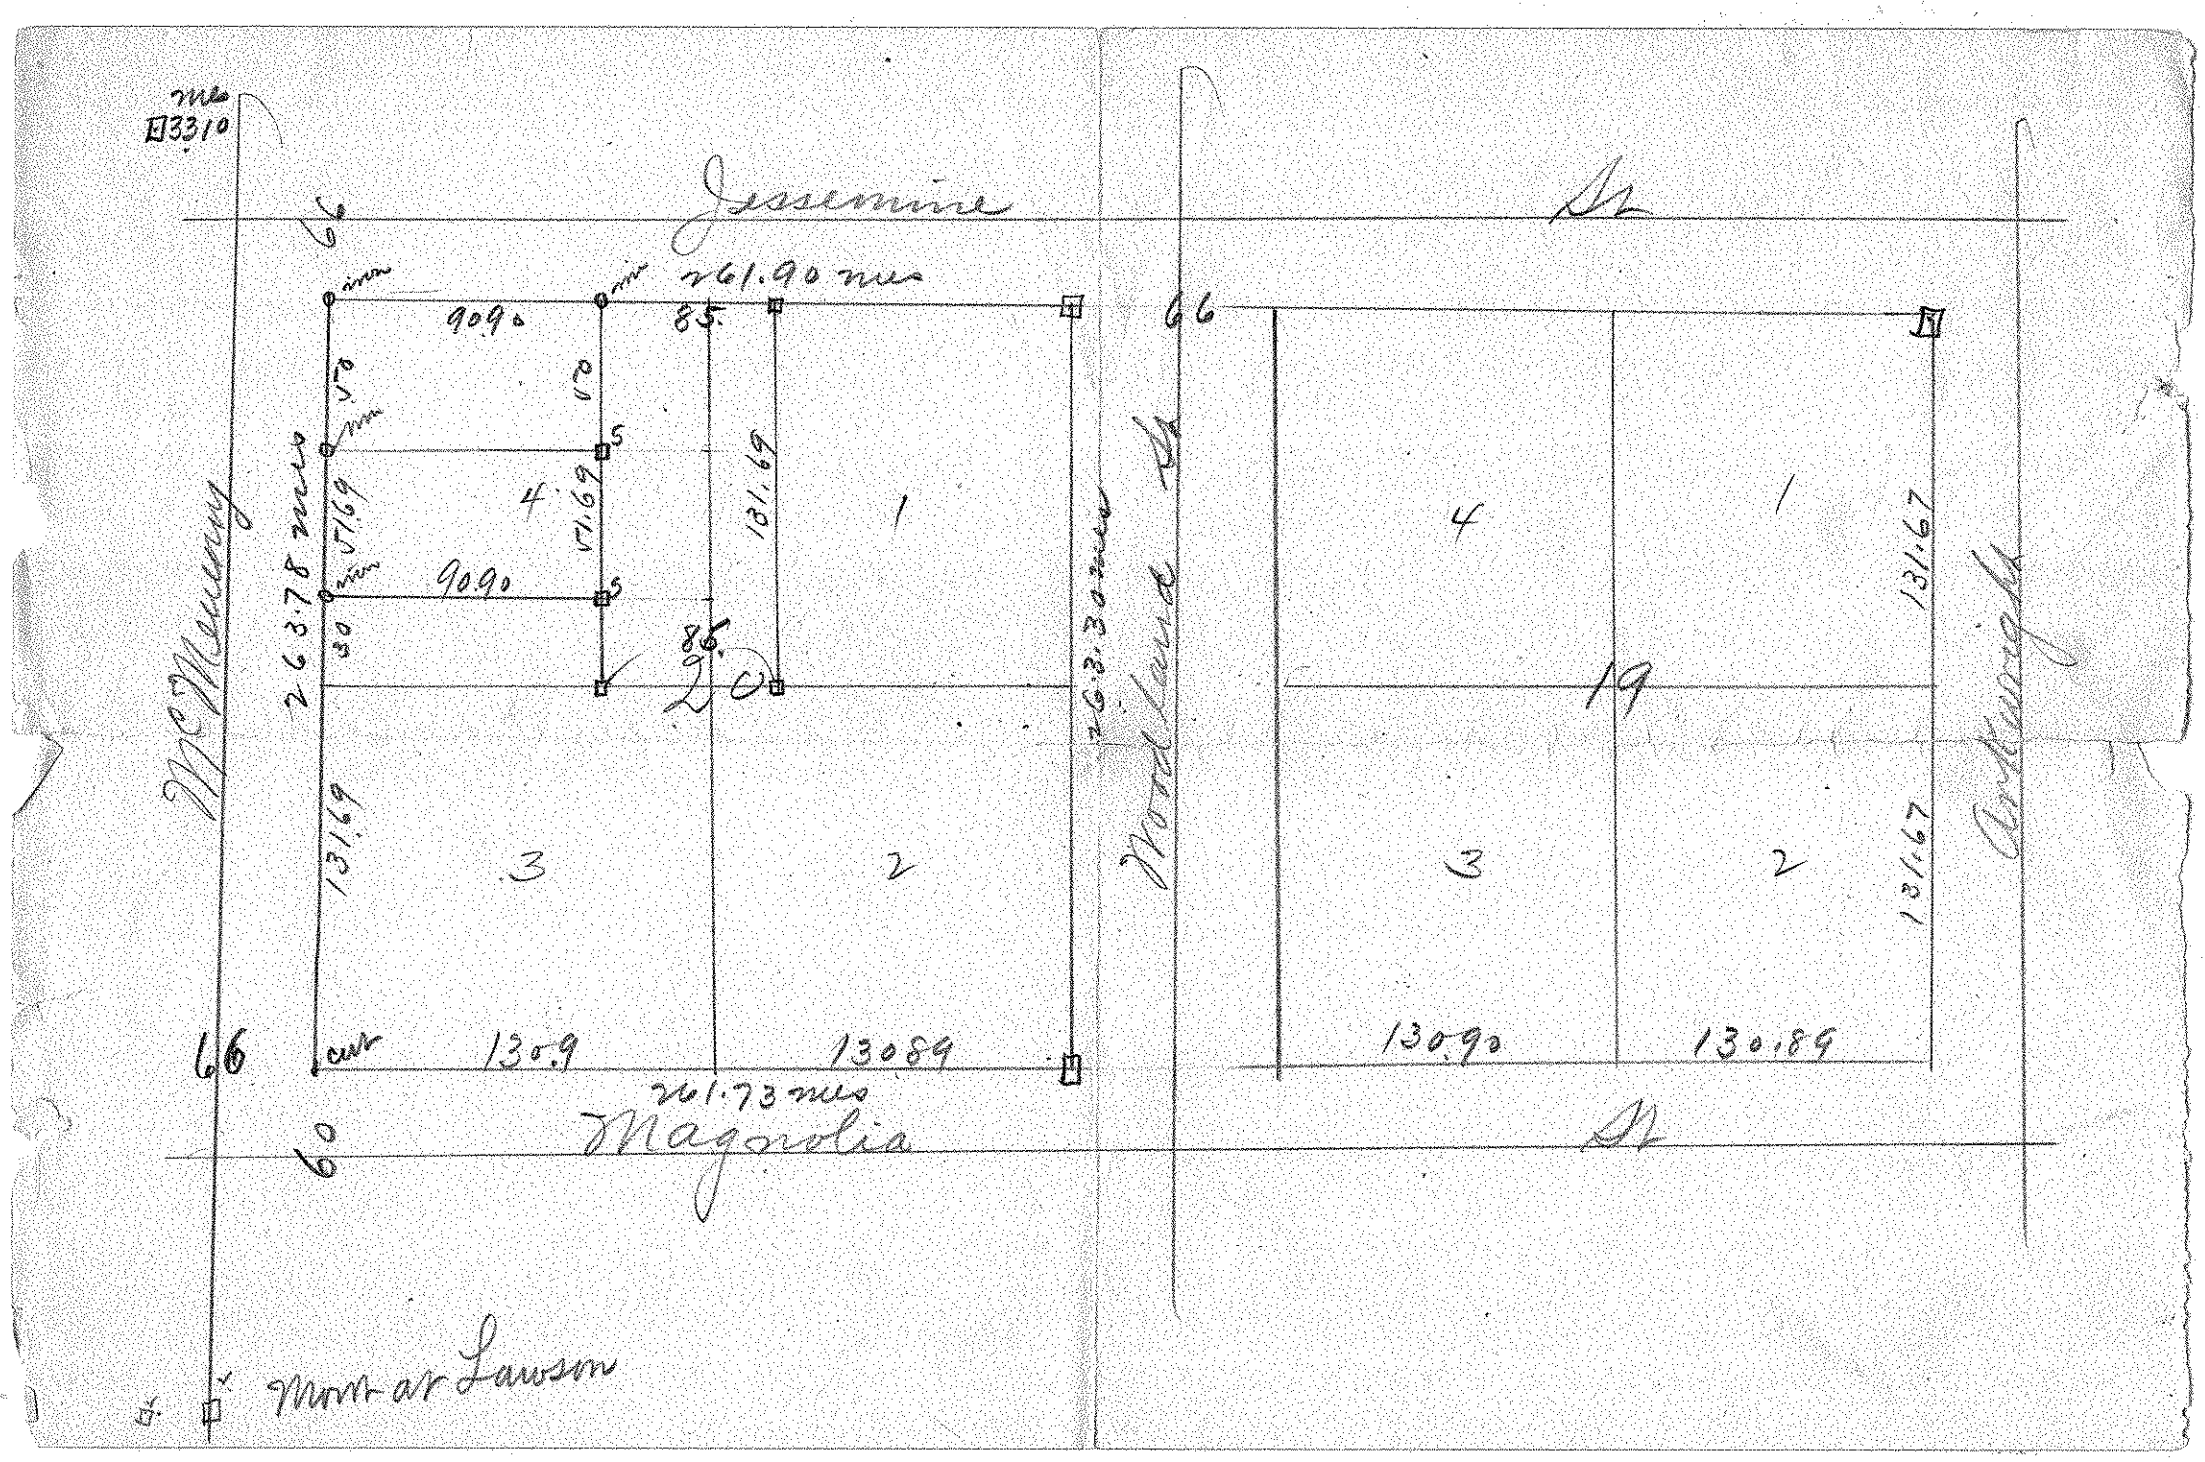

mes
3310
Jessemine
St
261.90 mes
90.90
85.
66
5
4
1
131.69
51.69
90.90
86.
20
263.78 mes
263.30 mes
McMenary
Woodland St
Arkwright
4
1
19
131.67
3
2
131.69
131.67
66
130.9
130.89
130.90
130.89
261.73 mes
60
Magnolia
St
Mont at Lawson