


June 1962 Adient Havers

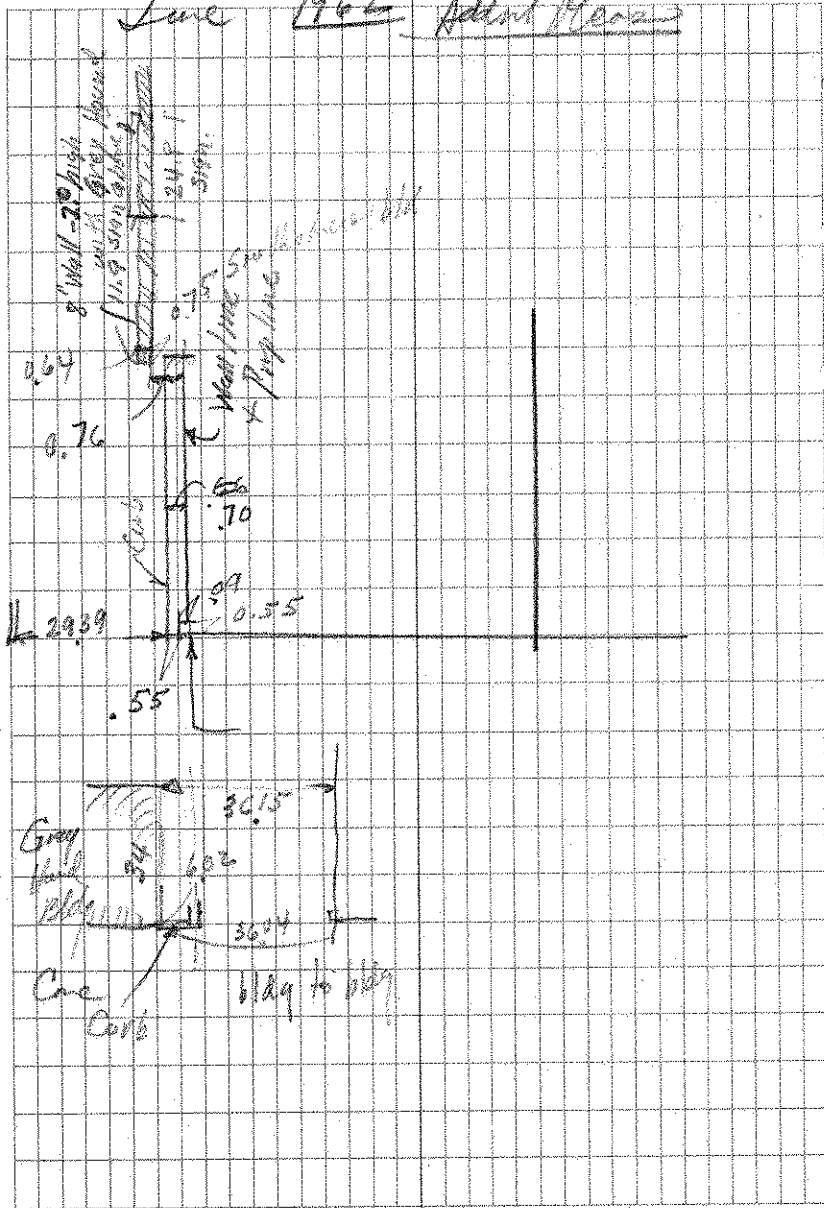

DIETZGEN NO. 3843