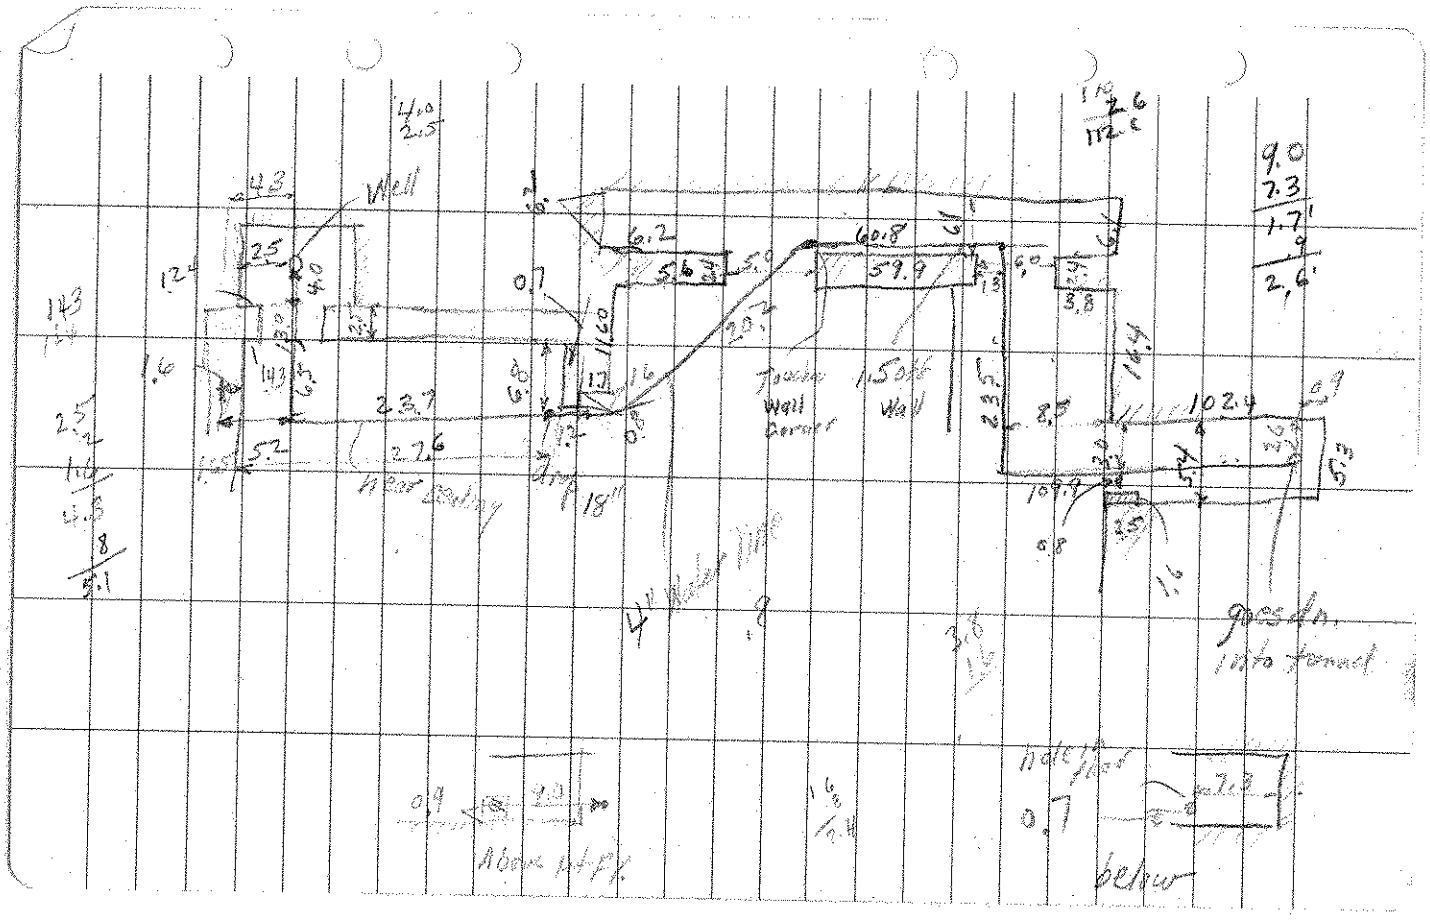
Well
Towards Wall Corner
150 ft Well
near seaway
drop
18"
4" Water line
goes in into tunnel
below