

Fig

101.42
58
100.84

304.68
304.25 R ÷ 3 = 101.42
101.42
101.2

3 | 304.178 = 101.39 or 1.19' approx

3 | 304.168 = 101.36 or 1.56' approx

3 | 304.15 = 101.38

304.25 R. M.
304.25 R. M.
304.25 R. M.

101.42
101.38
0.04
0.35" offset

50.95
50.03 M
50 R

dividing line
between
ltds.

250.20
250.00

8" line
4' beyond
corner
line


300.55 ft 5. and ldy.
50.09
300.19 by area
22 150.10

50

90° 13' M
89° 51'

0.2

305.84 ft ldy
305.51 ft ldy

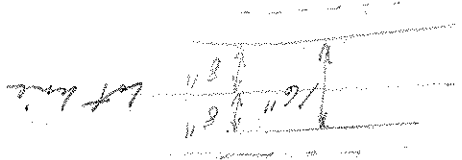

300.2 M

300.00
2.0