

**Certificate
of Survey**

CHARLES O. GEORGI COMPANY

2215 West County Road B Saint Paul 8, Minnesota
MINNESOTA REGISTERED LAND SURVEYOR


I Herby Certify that this plat shows a survey made by me of the property described on this plat, and that the corners are correctly placed as shown, and that all locations, encroachments, etc., have been correctly shown.

File — Ellerbe
Surveyed For St. Joseph Hospital
Date Oct. 1965 10/26/65 Included Hwy. Taking
Scale 1" = 50'

By Charles O. Georgi
REGISTERED LAND SURVEYOR

Description:

The Southerly 100 feet of Lots 1 and 2;
Lots 3 to 6 inclusive except that part taken for Highway purposes;
The Easterly 24.75 feet of Lot 9, except the part thereof deeded to the City of St. Paul in Book XX of Deeds, page 349;
Lots 10 to 13 inclusive;
Lots 14 and 15, except the South 100 feet of said lots;
all in Block 3, Bazil & Guerin's Addition to St. Paul.

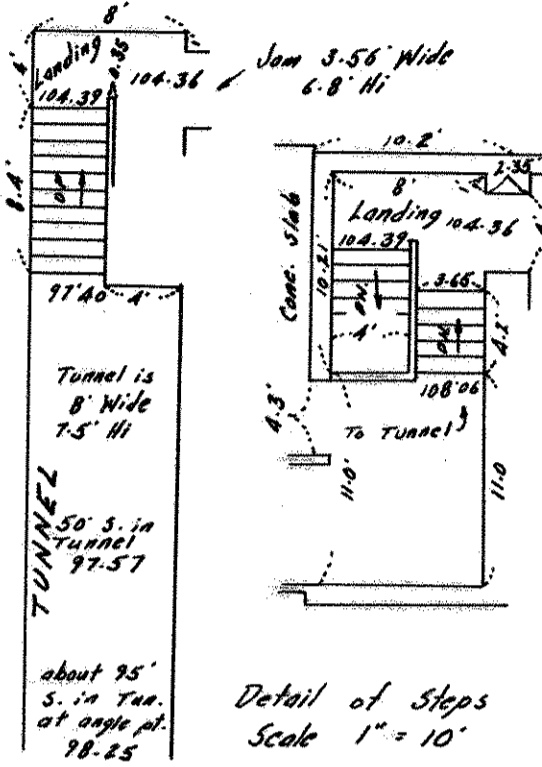

NOTE:

All Elev. are City Datum
B.M. 110.82 Top Hyd. S. side 10th by SW Cor. prop.

