


2 590
 17.15
 24.37
 67.42

Doc No 377483

all clear

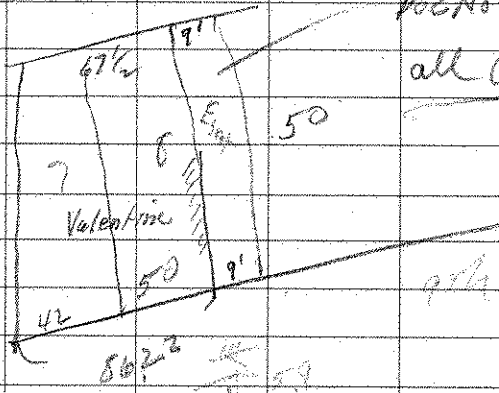

9 1/2

Valentine

86.01
 9 1/2

all clear