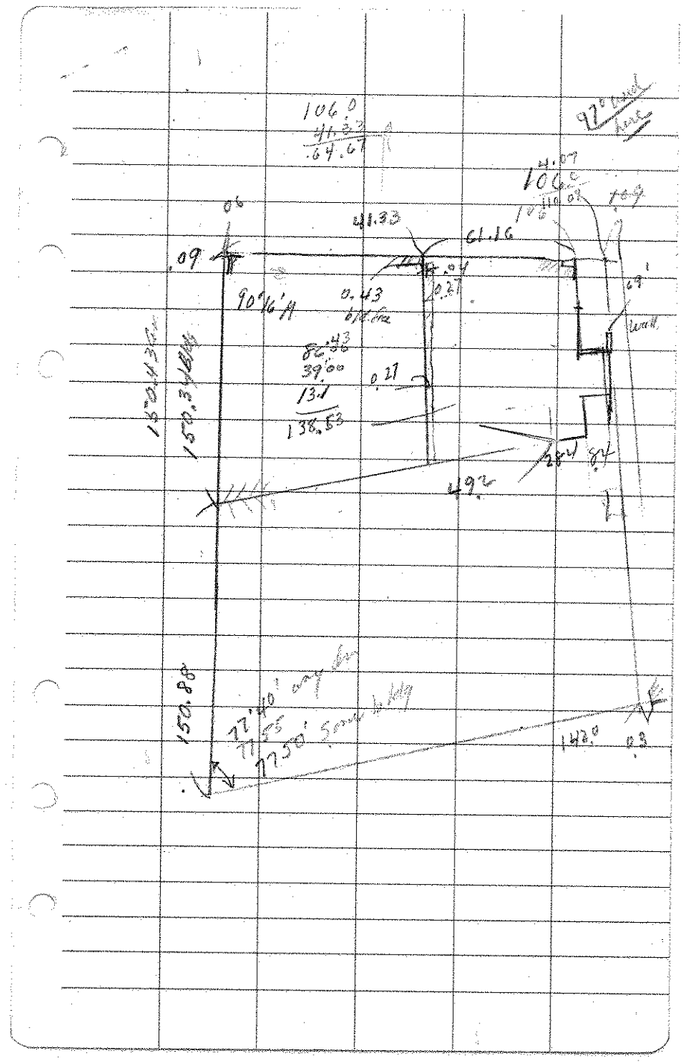
106.0
41.33
64.67
97° Land Base
106.0
4.07
102.03
41.33
61.16
0.43
0.27
90°16'
82.43
39.00
13.1
138.53
0.27
4.92
150.80
150.34
17°40' avg bk
17°55'
17°50' same as bkg
1+42.0
0.3

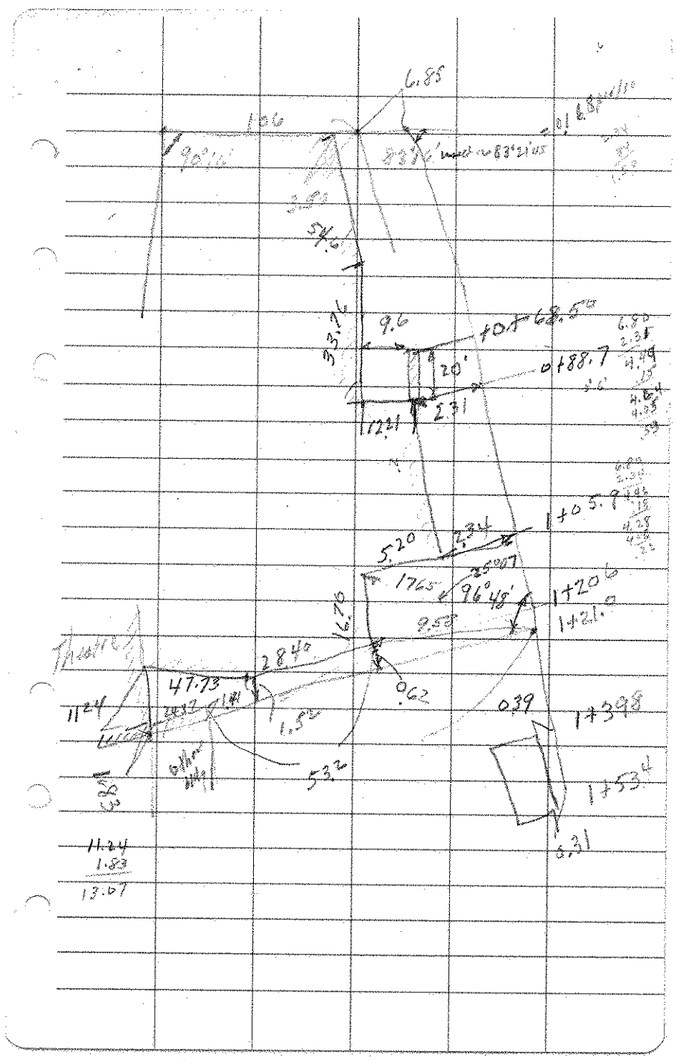
6.85
106
90°11'
83°22'
5%
9.6
0+68.50
0+88.7
20'
2.7
122.1
1+05.9
5.20
1765'
96°48'
1+20.0
1+21.0
9.52
Thence
47.73
28°40'
0.62
1.5%
53°32'
0.39
1+39.8
1+53.4
5.31
11.24
1.83
13.07

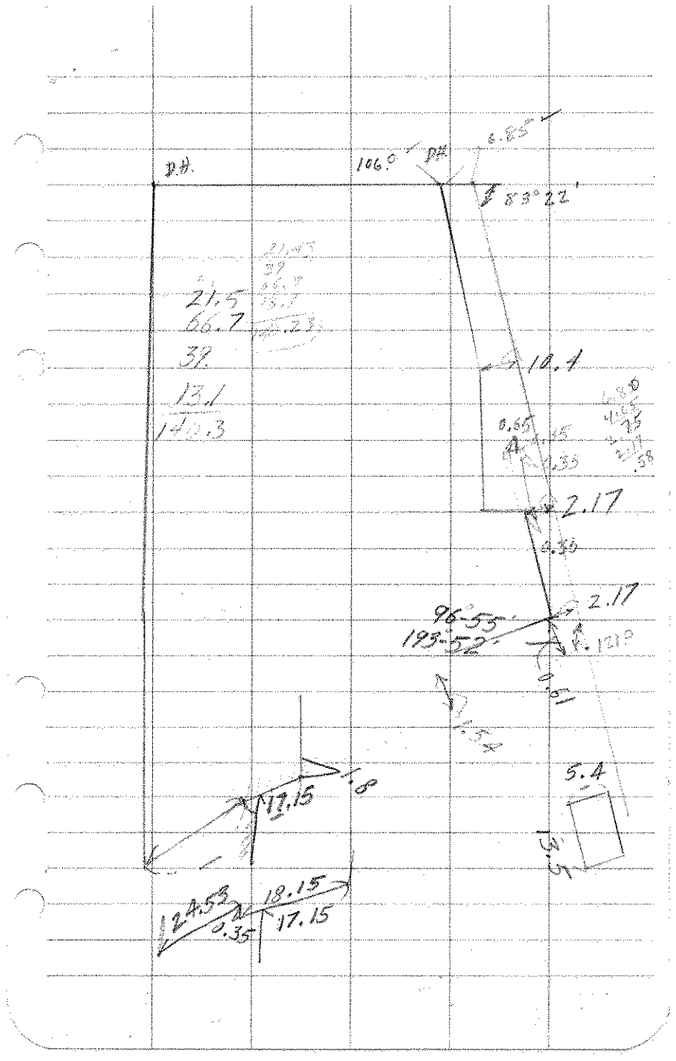
P.B.
106.0°
P.T.
6.85
83°22'
21.5
66.7
32
13.1
141.3
10.1
0.65
2.17
4.50
2.17
96°55'
193°52'
R. 120°
12.5
5.4
17.15
1.8
24.53
0.35
18.15
17.15