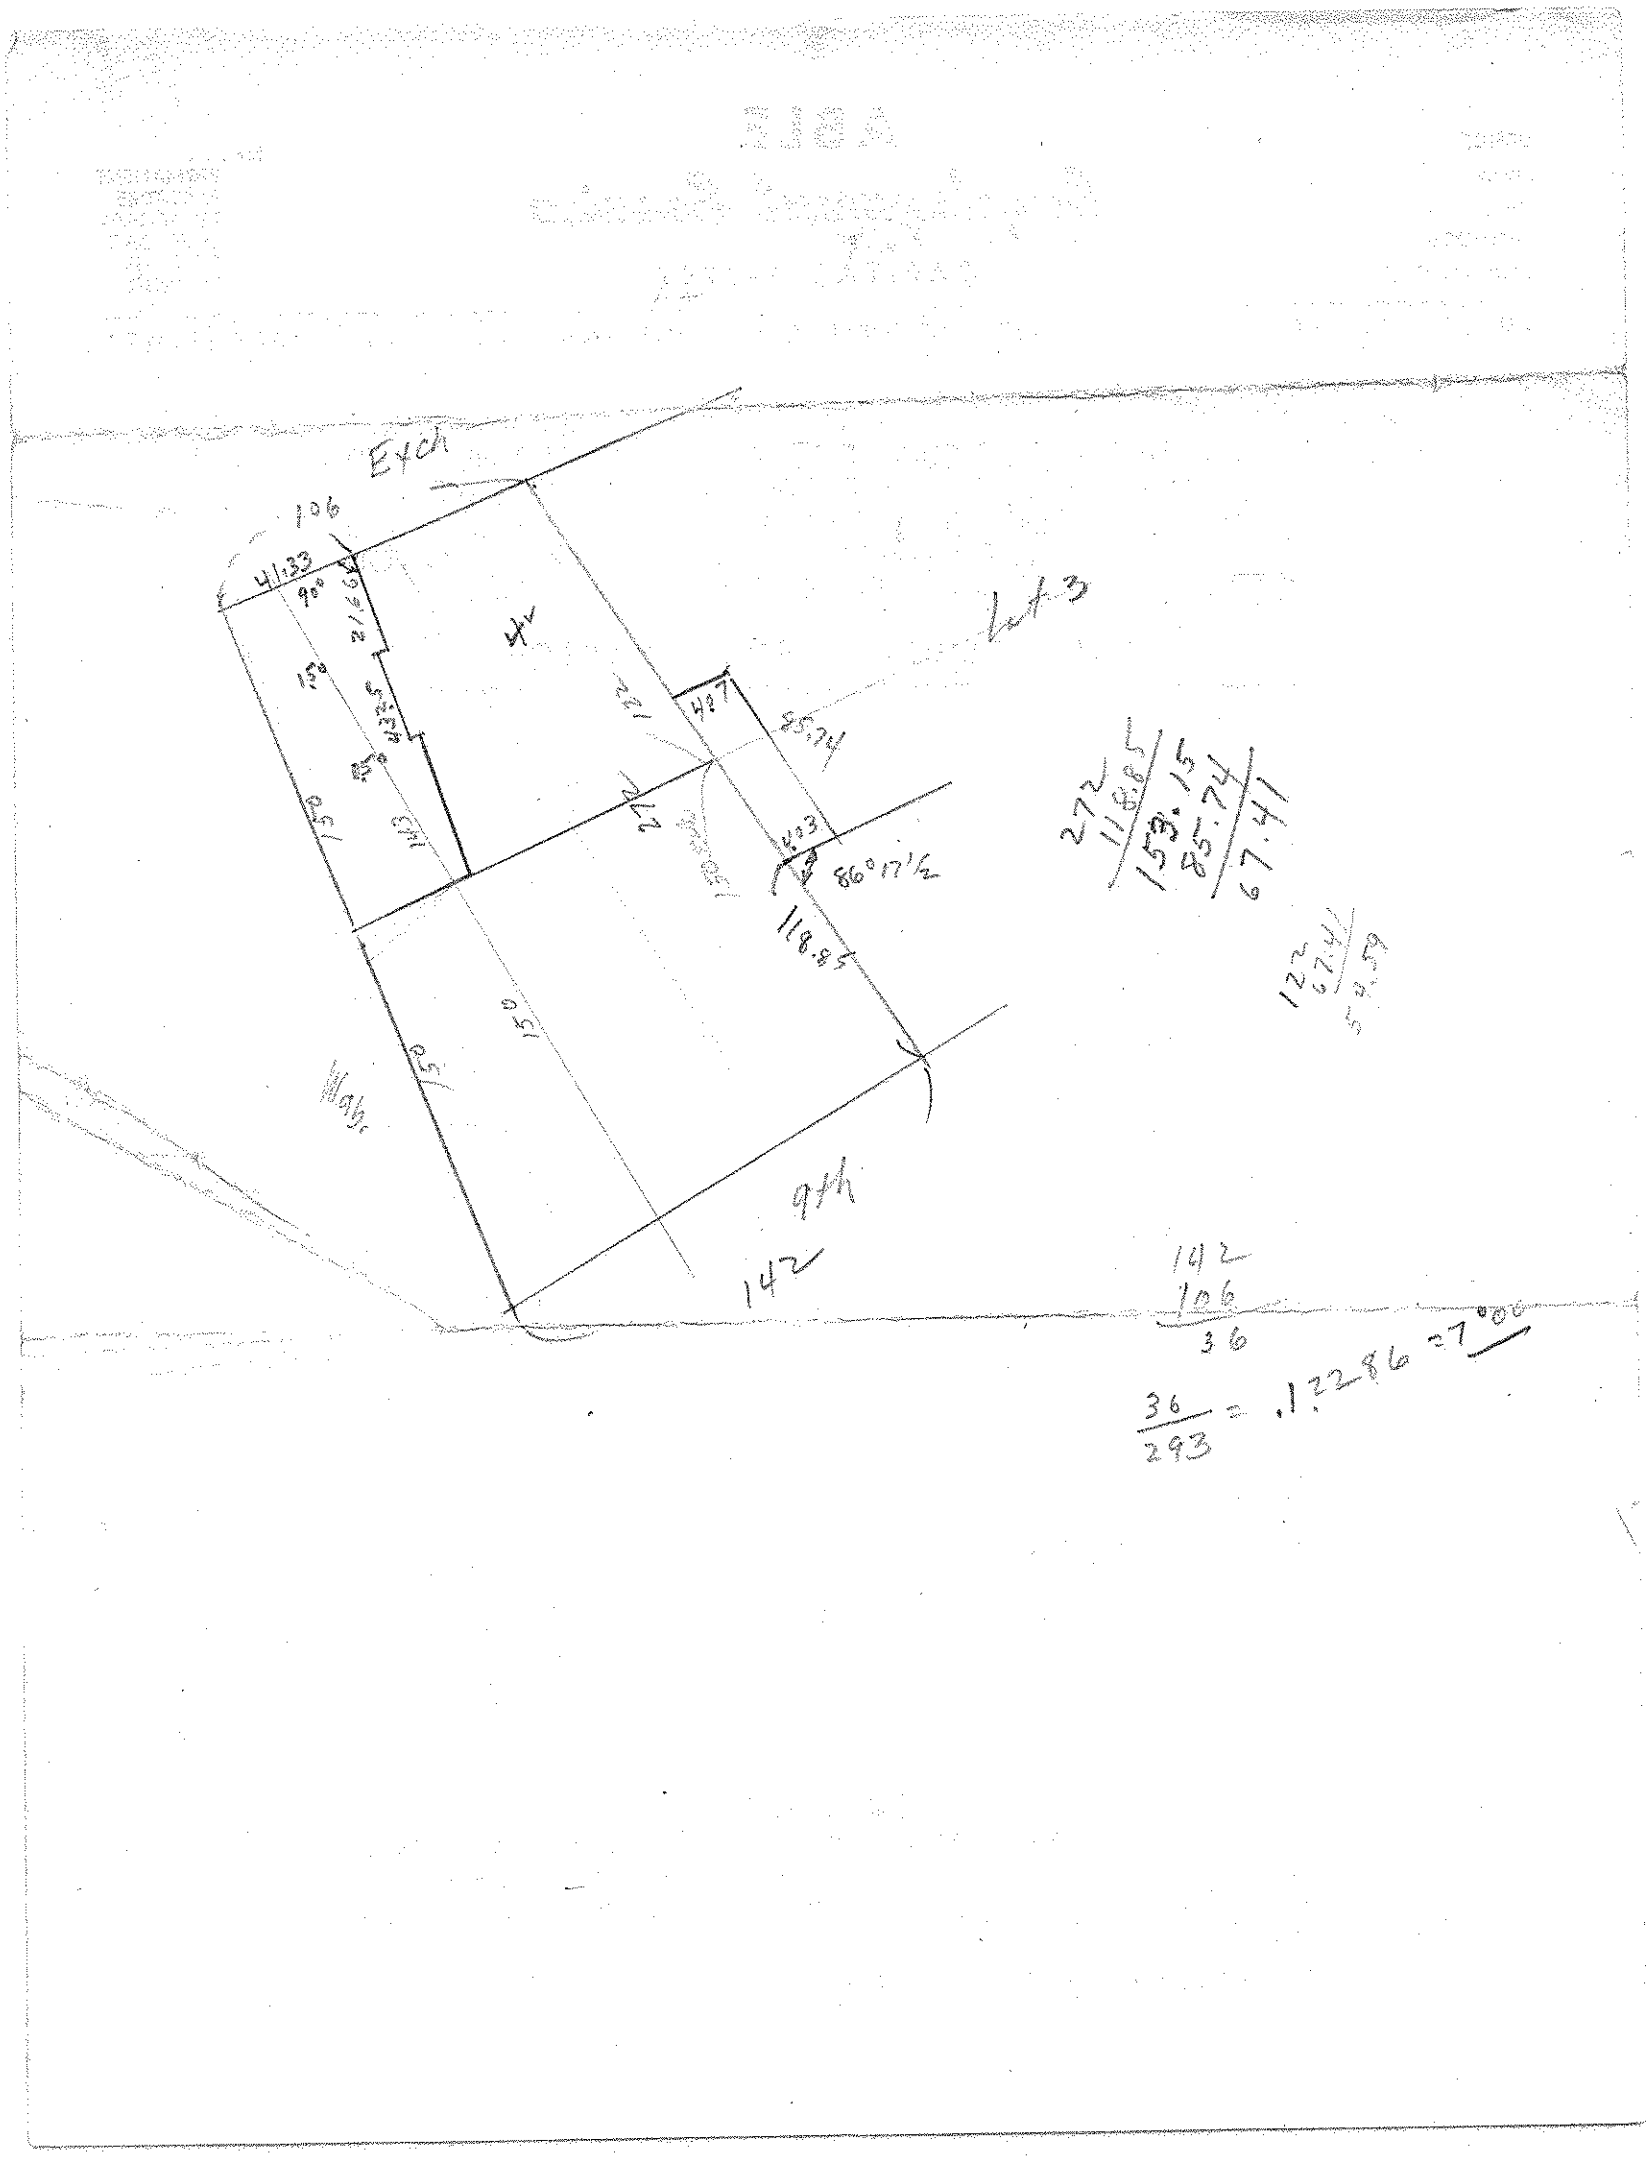
Etch
106
4/133
9°
2 1/2
15°
43.5
45°
4'
122
4'7
85.74
Lot 3
272
118.85
86°17½
118.85
150
Walk
9th
142
272
118.85
153.15
85.74
67.41
122
67.41
54.59
142
106
36
36/293 = .12286 = 7.00