


1188A

Exch.

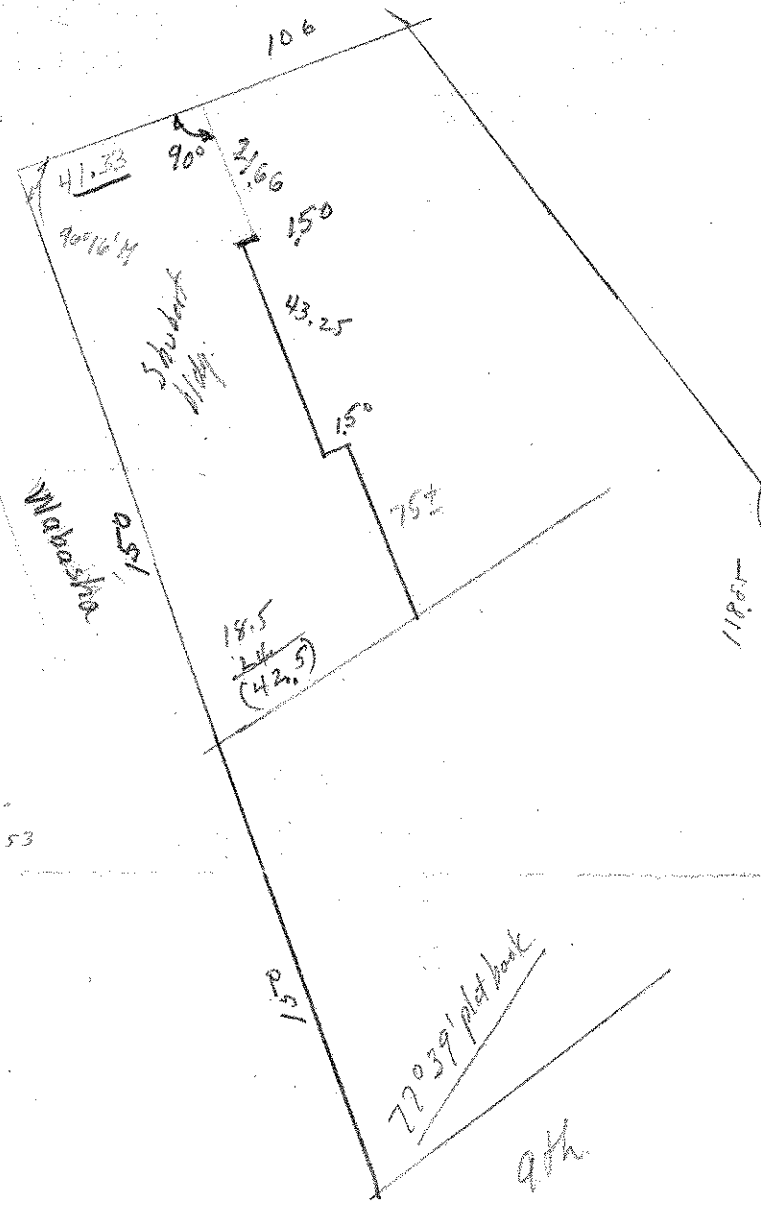

Wabasha

1188A

$\frac{66.761}{197.99}$
 981
 $\frac{20.161}{194.02}$
 136
 $\frac{192.79}{107}$
 191.72

55
 41
 $\frac{136}{107}$
 2.60

$\frac{13.57}{3.51}$
 $\frac{191.72}{294.2}$
 $\frac{22.56}{2.94}$

208.53

1/2

dimension