P947×48 plat book

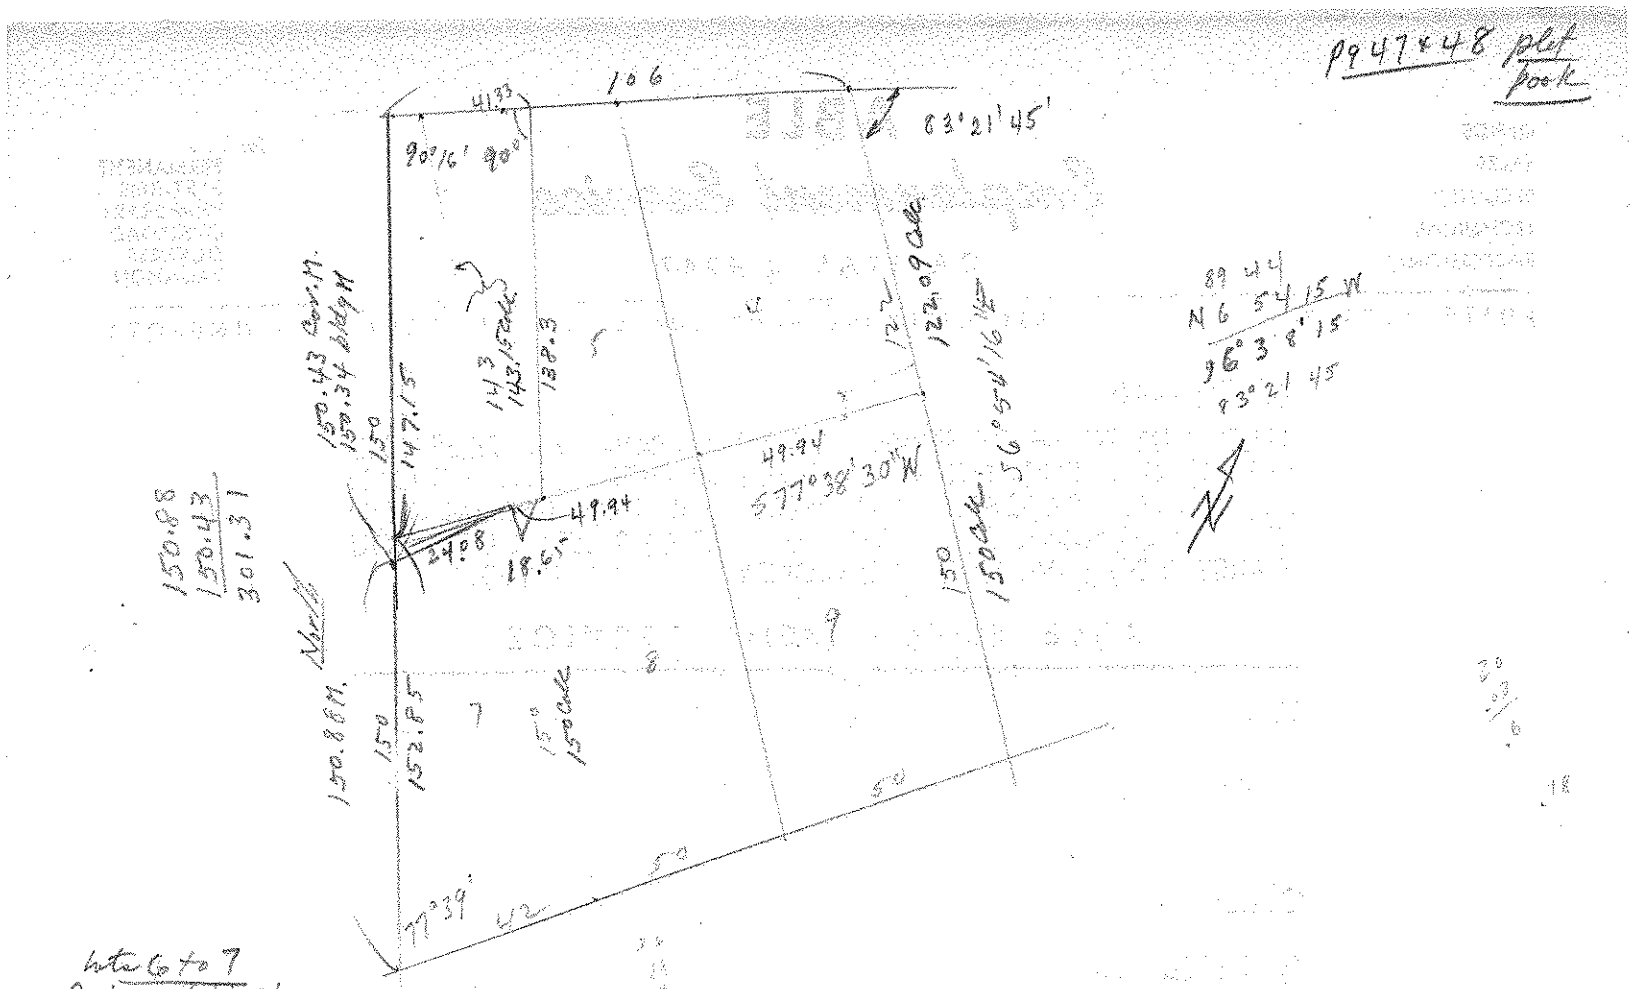

Lots 6 to 7
Portion of bl. Closure

		N	S	E	W
00445343 9779892	S 89°44'W 6.0				
	South 300		300.00		
213 8829 9762593	N77°39'E 42	8.98		41.03	
		291.05	35.03		

tan B = .120357
6°51.47"
293.15 ~ 293

Lots 4 to 9

		N	S	E	W
	S89°44'W 106				
	South 300		300.00		
	N77°39'E 142	30.37		138.71	
		270.12		32.71	

tan B = .12109
S 6°54'16" E
272.09 ~ 272

89 44
6 54 16
106 38 16

Lot 6

		N	S	E	W
992-235 119 497	N 6°51'47"W 143.15	142.12+			17.11
	S 89°44'W 6.0		.03		6.00
	South 150		150.00		
	N 77°39'E 24	7.91		23.11	

992-748 120 214

Start check
293.161
N 73°42 49"E
d = 24.08
77°38 26"

∴ not off line.	24	5.13		
	25	5.34		

If 77°39' 23.65 5.06 23.11

Then 150 Shouldbe 147.15

Lots 5+4

		N	S	E	W
	N 6°54'16"W 122.09	121.20+			14.68-
	S 89°44'W 100.00		0.46+		100.00
	S 6°51'47"E 143.15		142.12+	17.11	
	N 77°39'E				
		21.38		97.57	

tan B = 219134
77° 38 26"
d = 99.88

		N	S	E	W
	S89°44'W 41.33		0.19		41.33
	South 150.00		150.00		
	N 73°42'50"E 24.08	7.91		23.11	
	N 77°39'E 18.65	3.99		18.22	
	North 138.29	138.29			