


World

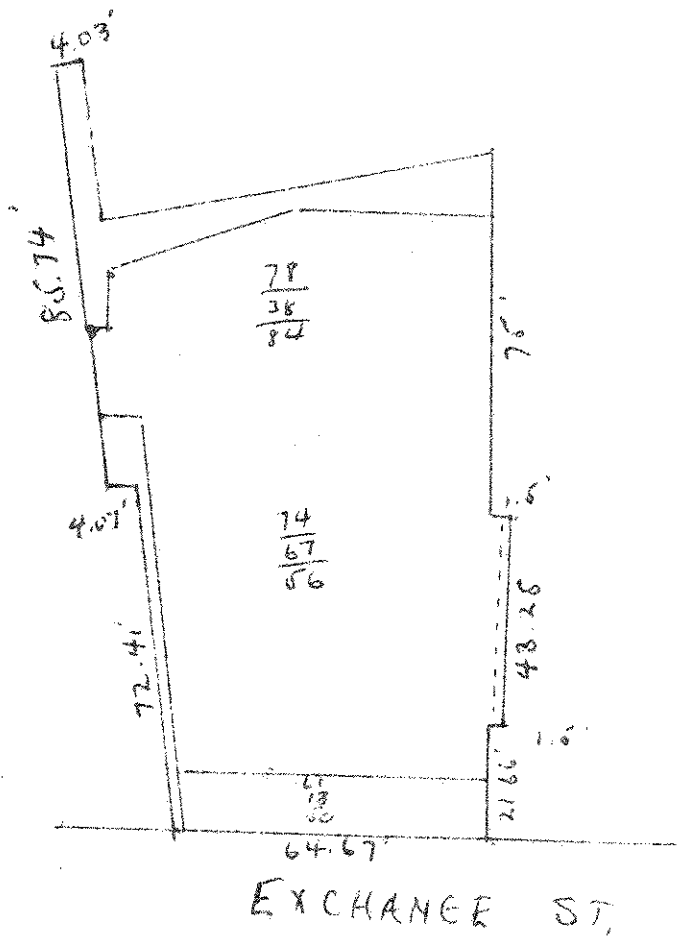

1906