FLANDRAU S.T.
CONNECTS TO MINNEHAHA
11-5-96
1.8 F.

Note Beacons Rec (N. of 5th) Puts E of Flandrau 1/2 ways between W&B + Kennard Orig. Plat of Lees Suburban (South of 5th St) Puts 2 1.5' West of (2 Way Point F.)

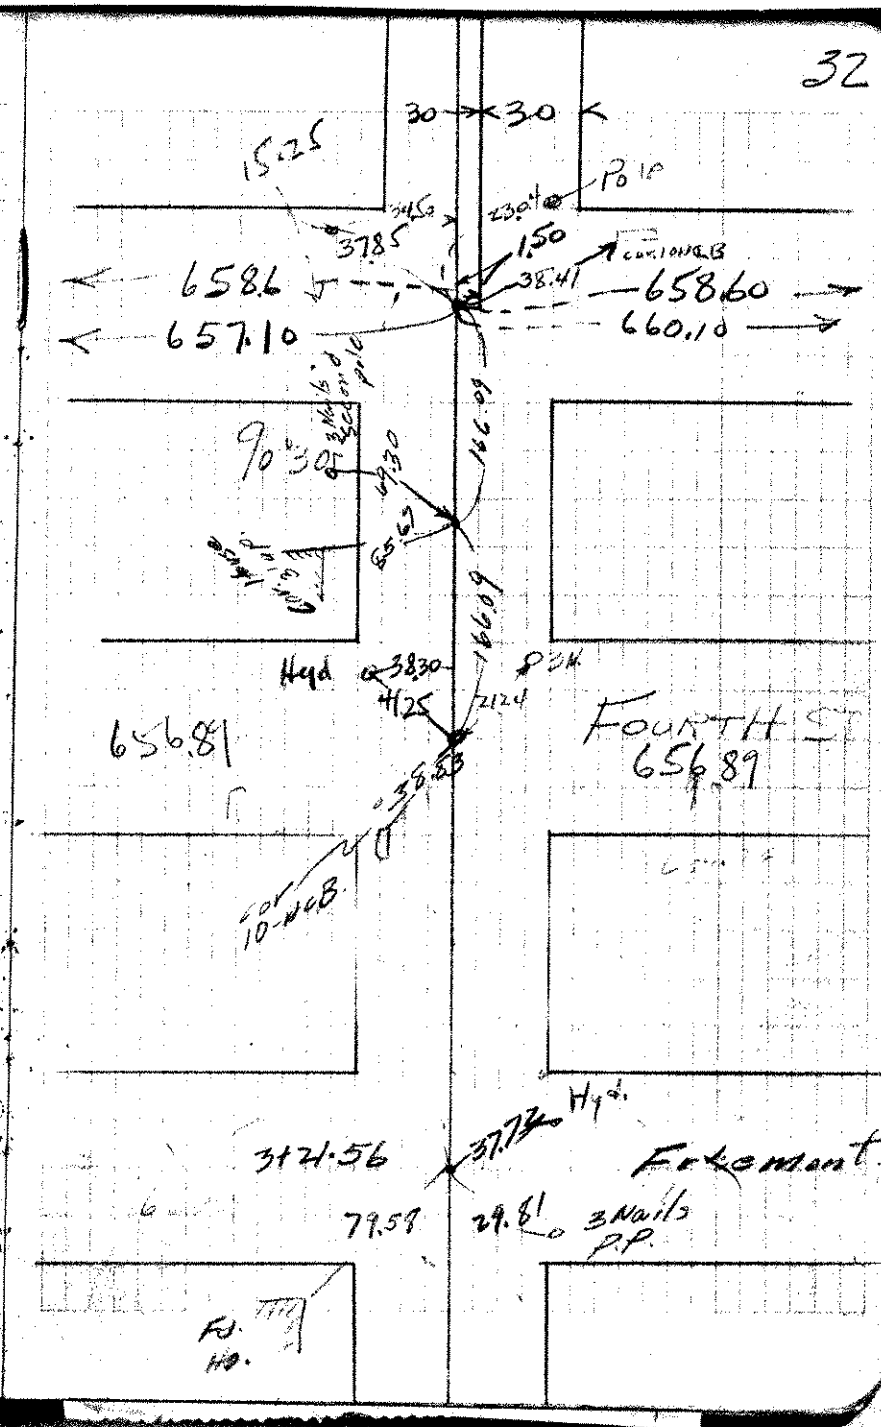

FB 1382