


26+1680 1/4 COL RUTH AVE.

1340840 1/4 LINCOLN HARSEL AVE

(L HARVESTER (CASE) AVE
WHITE BEARTO RUPH
JAN 26 - 1947 J.S. FORSEBERG)

615420 E VAN DYKE ST.

0700 W WHITE BEAR AVE.

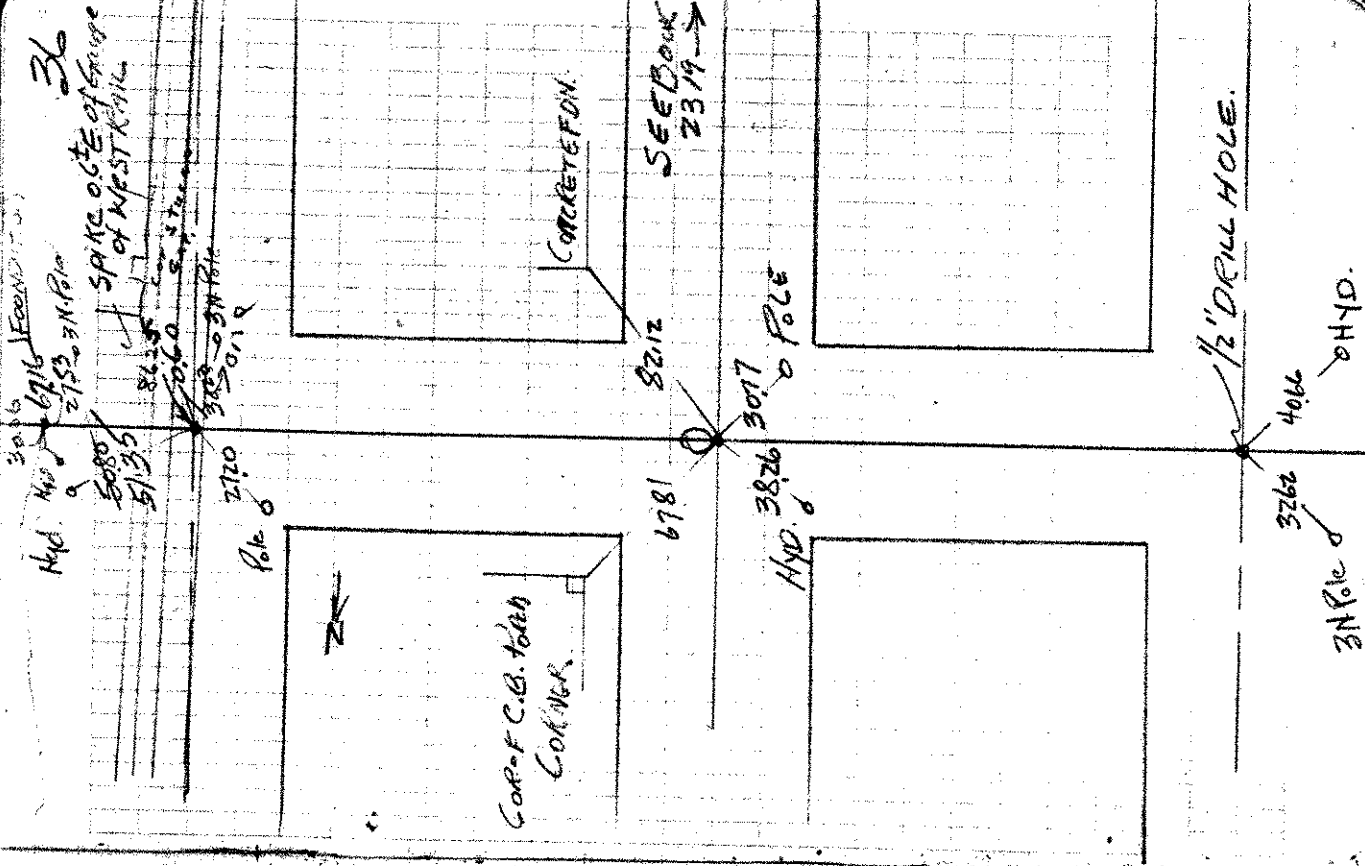

FB
1382