FB 1501A

transit tie

Tag & 22

10-7-82
Cutting-Graven-Enyeart-Binns
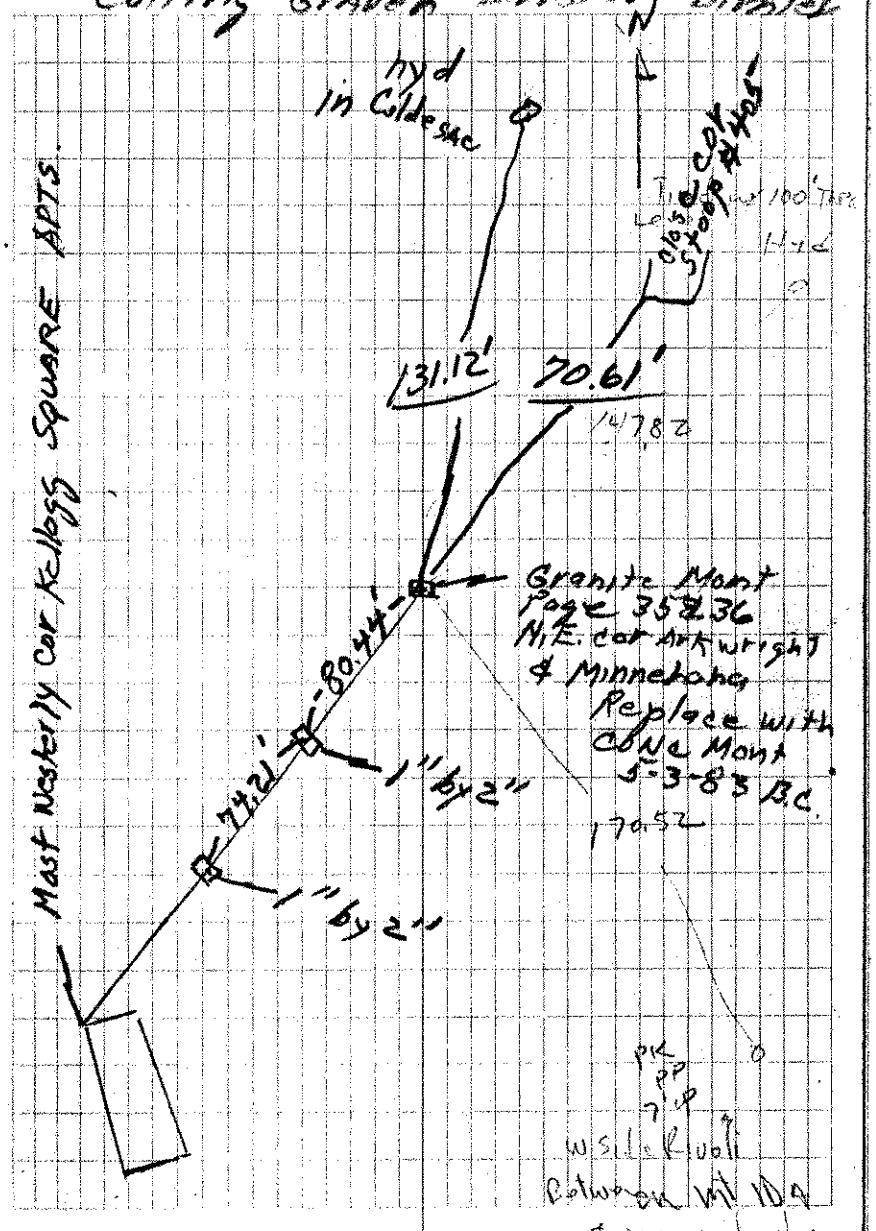
42