NE 5 29 22

FROM THE OFFICE OF

CHARLES O. GEORGI COMPANY

2215 West County Road B Saint Paul, Minnesota 55113

REGISTERED CIVIL ENGINEER AND LAND SURVEYOR

Certificate of Survey

I Hereby Certify that this plat shows a building location survey made by me on the property described on this plat, and that all locations, have been correctly shown.

Date February 19, 1976

Scale 1" = 40'

By Charles O. Georgi
REGISTERED LAND SURVEYOR

Surveyed for: Douglas Kubera

Description:

Lot 5, Block 2,
GREENBRIER WOODS
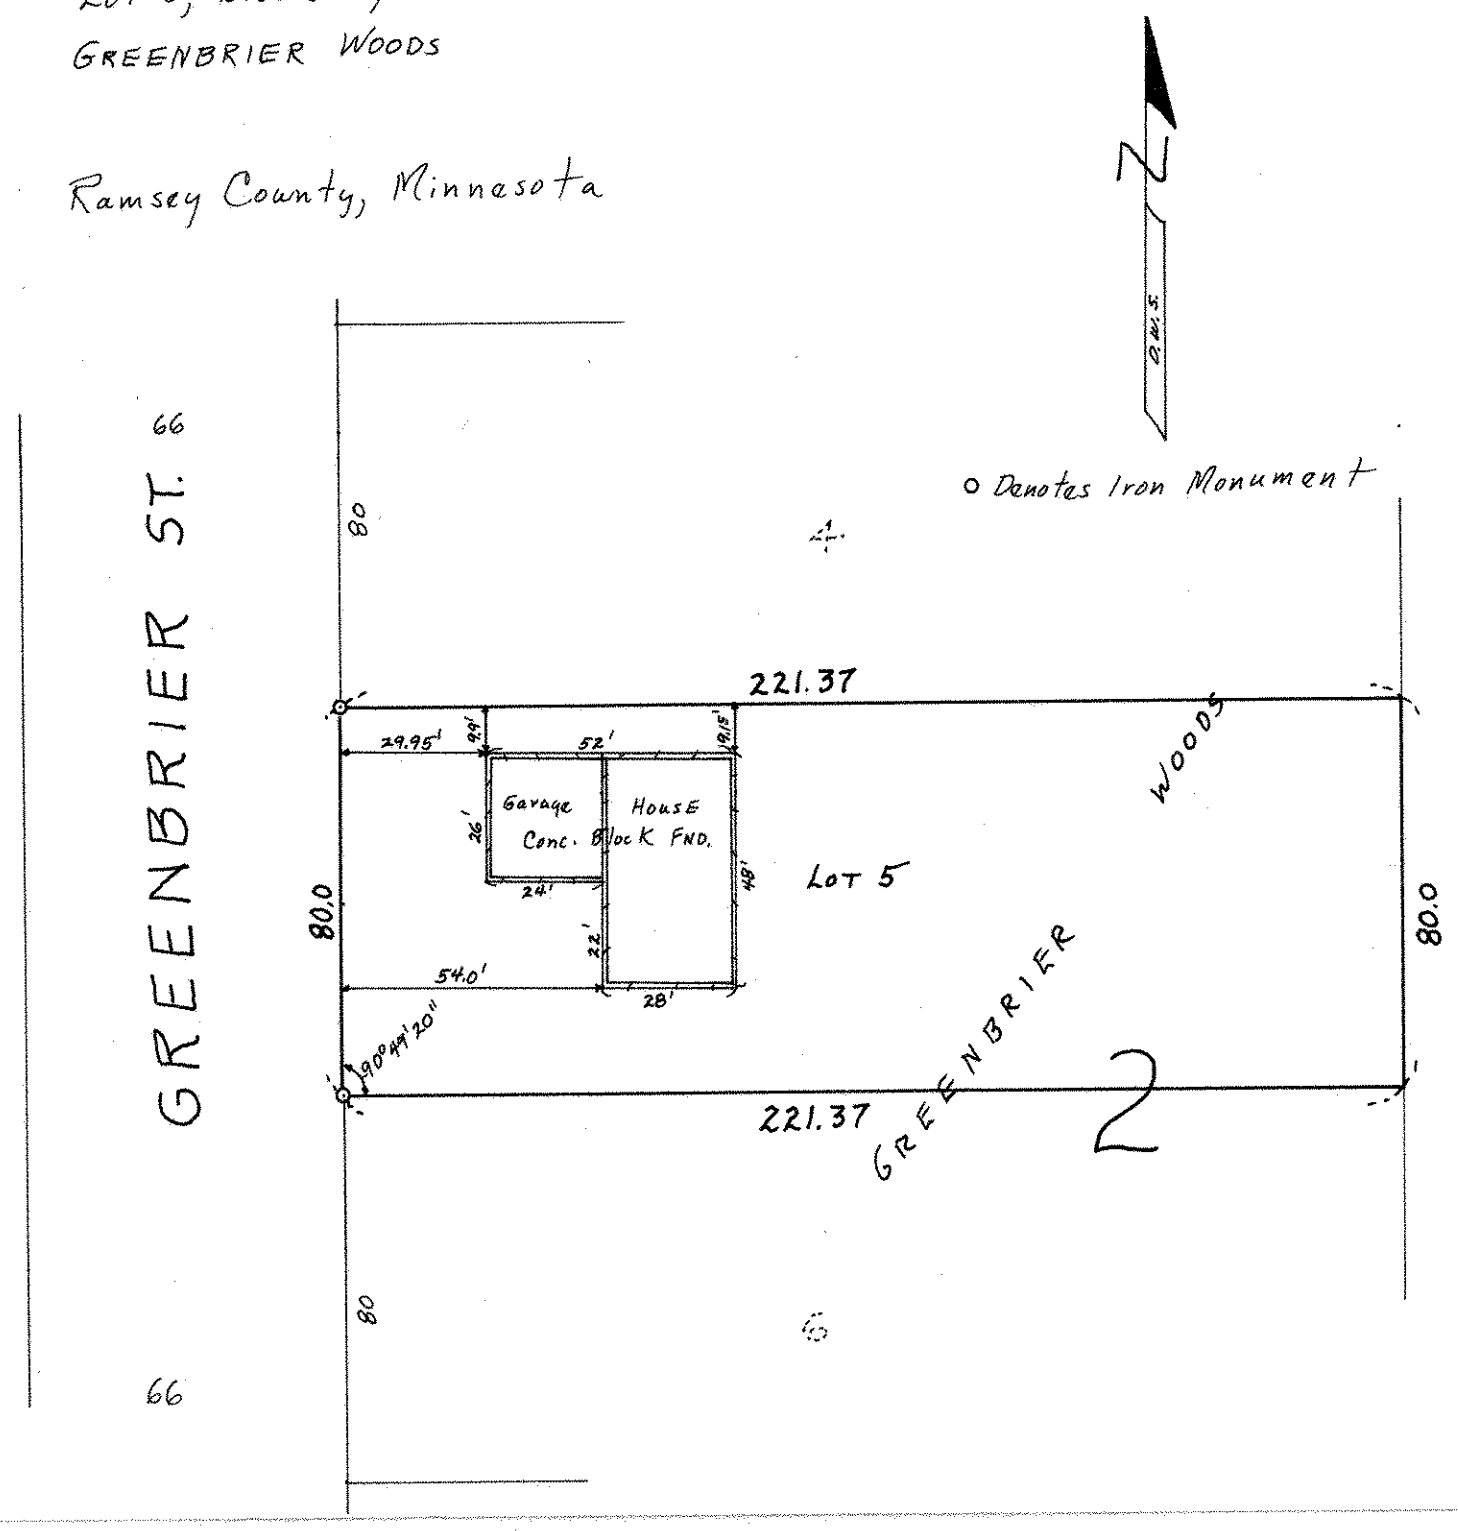
Ramsey County, Minnesota