

FROM THE OFFICE OF

CHARLES O. GEORGI COMPANY

2215 West County Road B

Saint Paul, Minnesota 55113

REGISTERED CIVIL ENGINEER AND LAND SURVEYOR

Certificate of Survey

I Hereby Certify that this plat shows a survey made by me of the property described on this plat, and that the corners are correctly placed as shown, and that all locations have been correctly shown.

Surveyed For F.J. Horner Co.


Date January, 1971

Scale 1"=40'

By Charles O. Georgi
REGISTERED LAND SURVEYOR

Description:

The North 34 feet of lot 12, and the South 42 feet of lot 13,
Block 6, Hillside Homesites, Ramsey County, Minnesota.

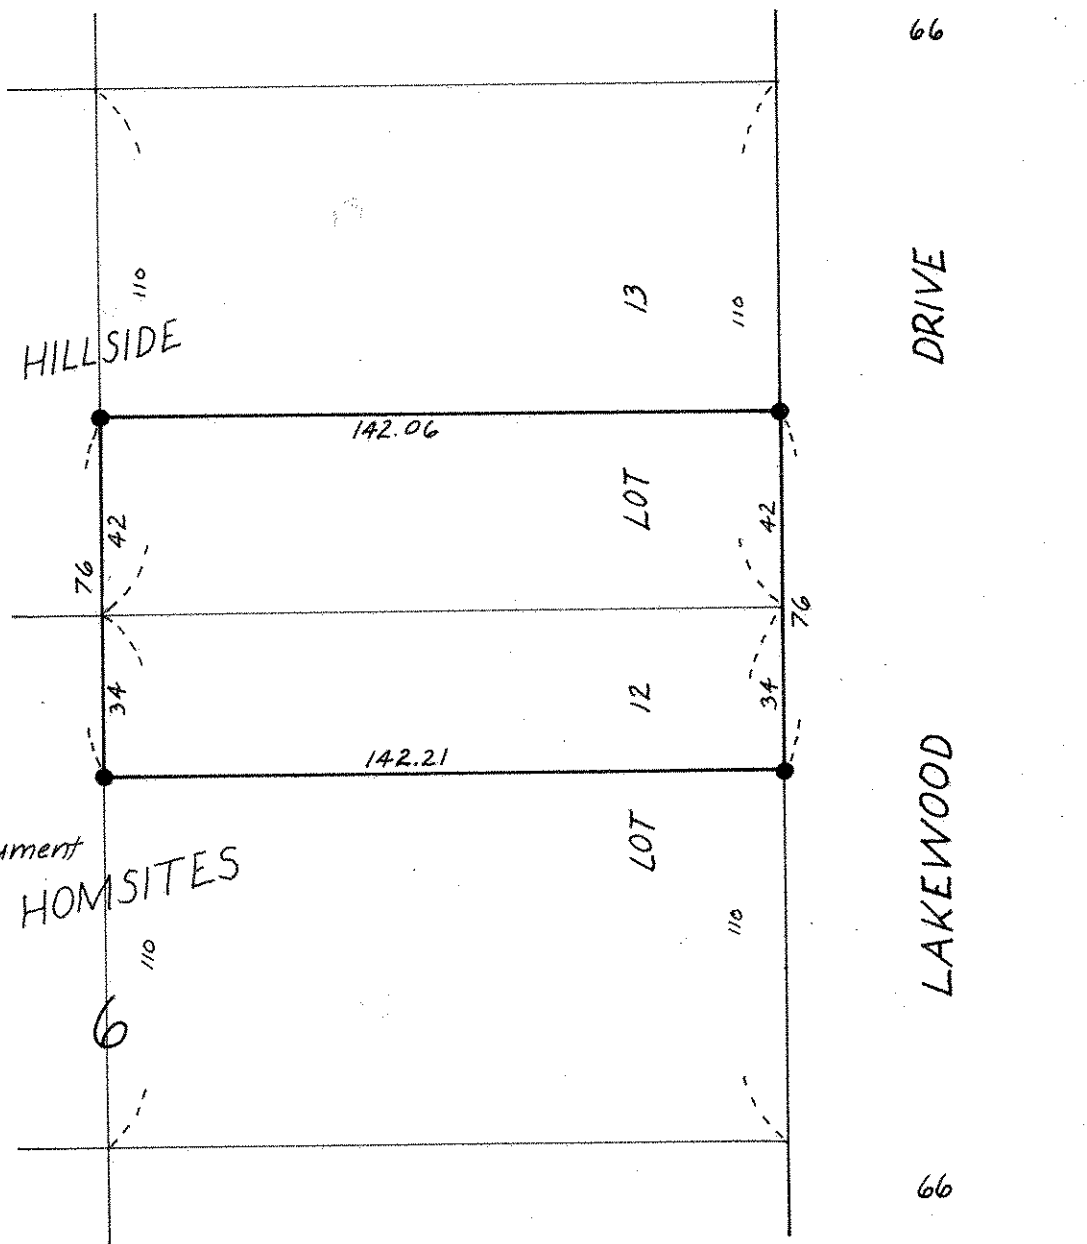

● Denotes Iron Pipe Monument found in place