Lawrence Anderson.

N 103' of that part of the W 8 Ac. of W½ of SE¼ of SE¼ of Sec 16 29 23 dev on fall inc the W'ly 147' thereof.

page 312

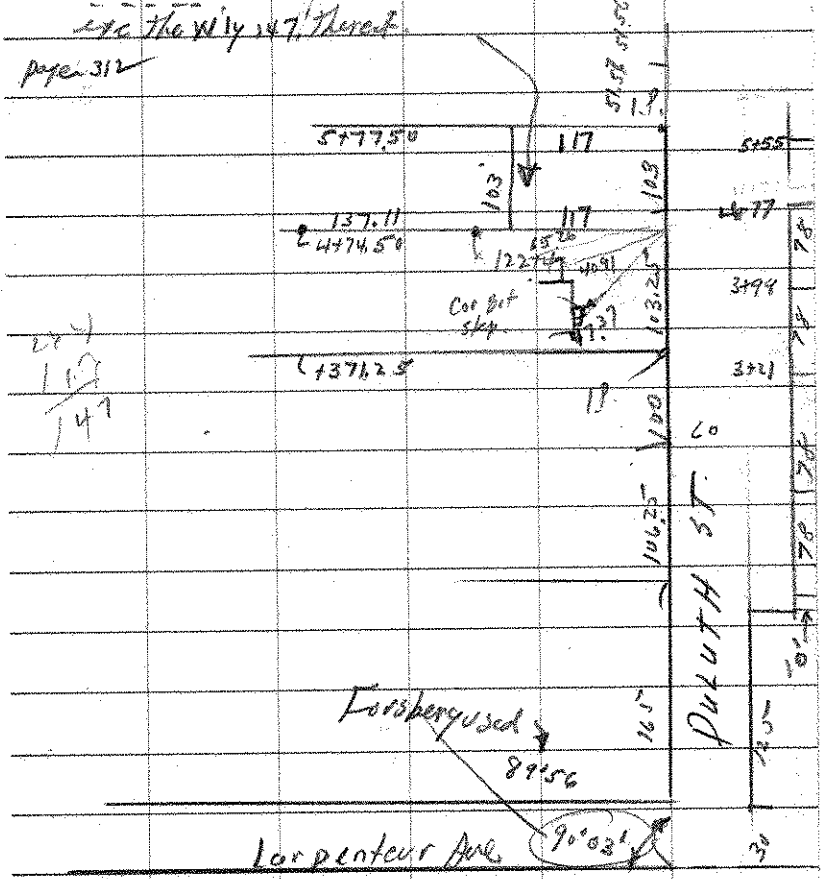

DIETZGEN NO. 384-S