


LOTS 8, 9 AND J. W. BASS'S  
GARDEN LOTS

Scale 100 Feet pr. inch

• = Stake

SP  
COURTLAND ST

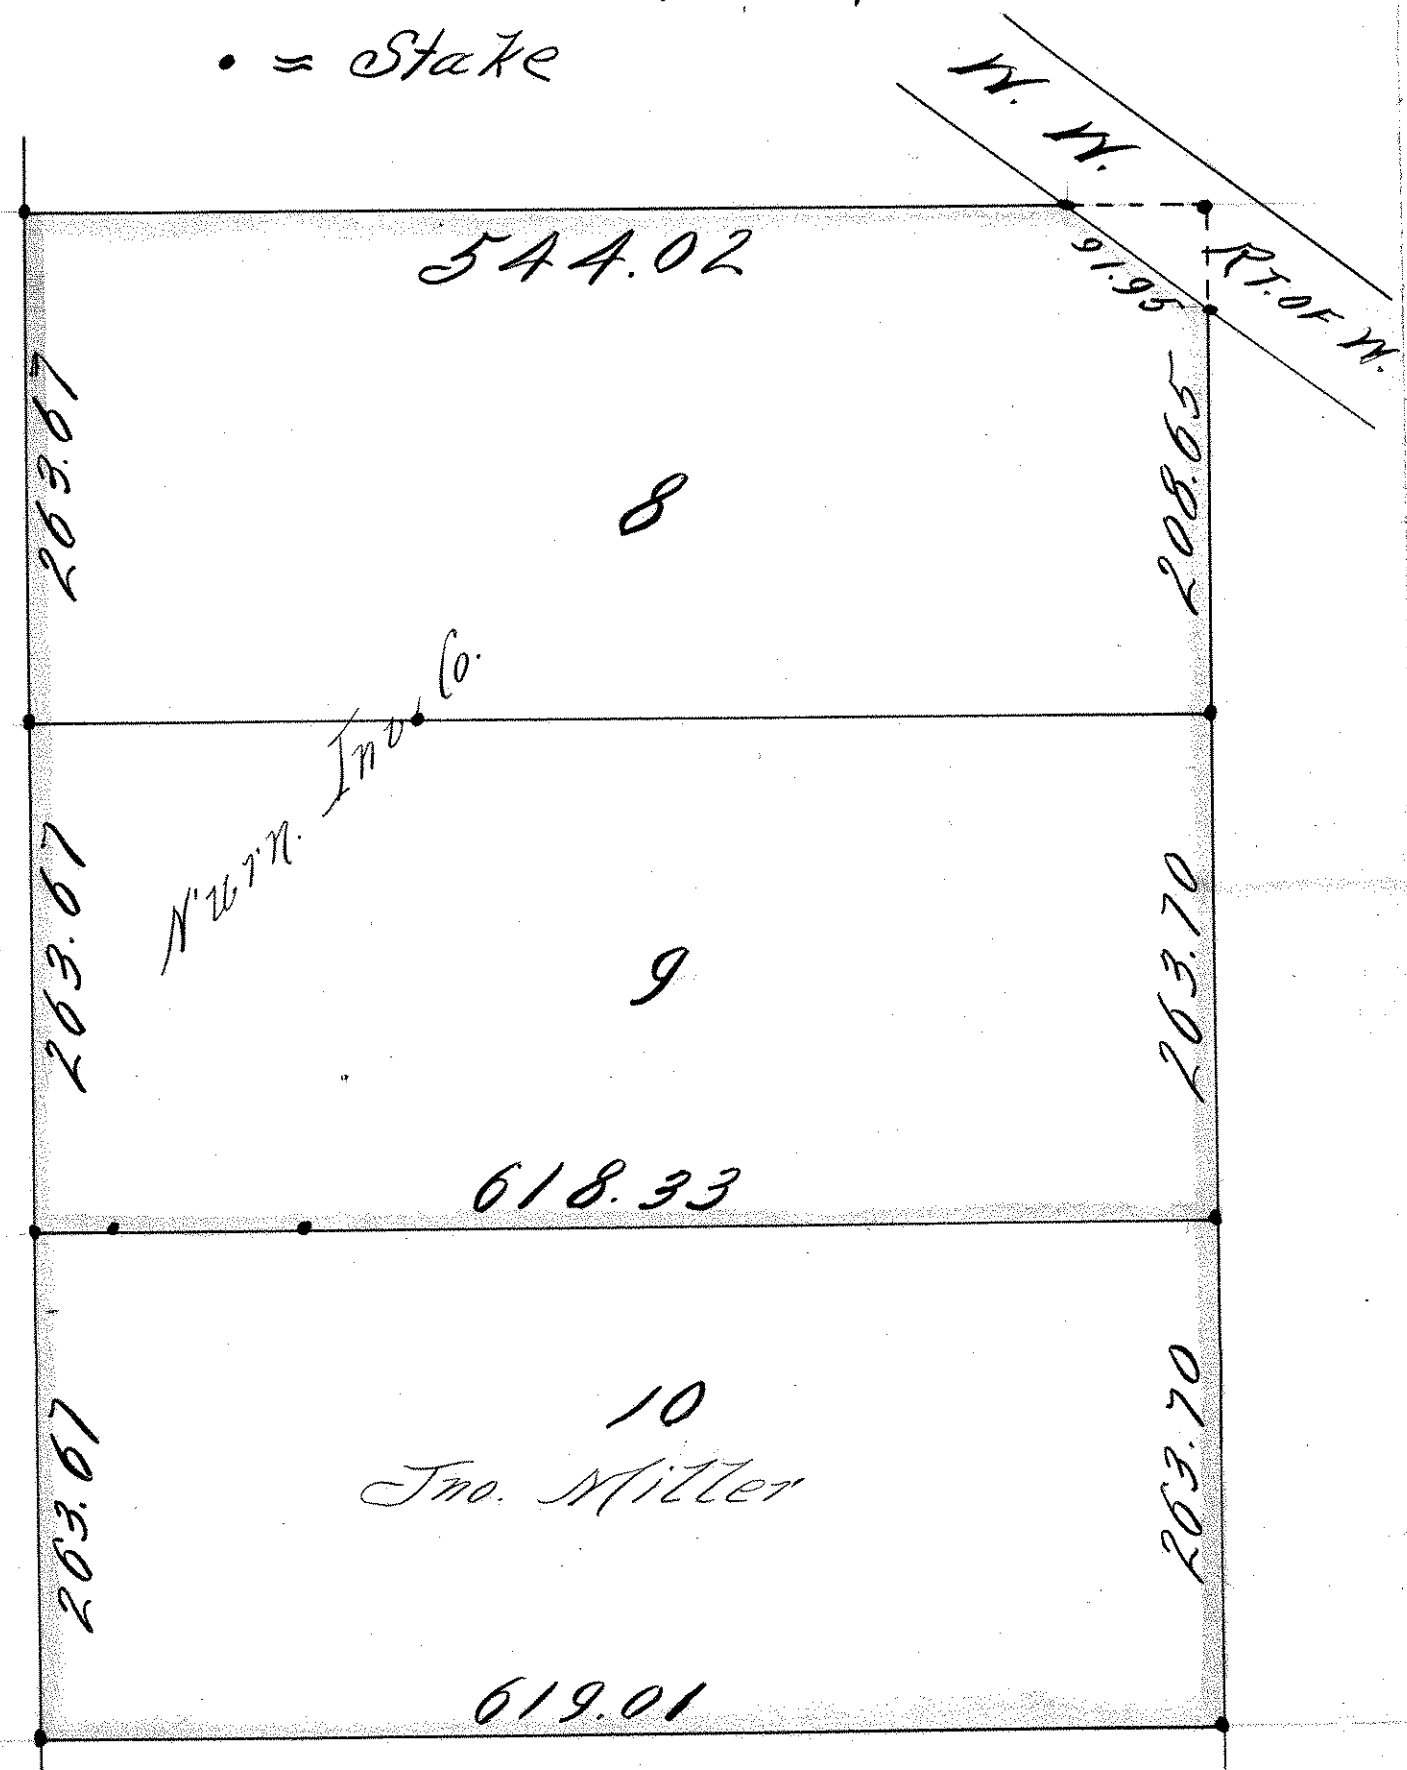

June 6<sup>th</sup> '03 Jno. Miller