


LOT 6 EXCEPT SOUTHERLY 1 ft.
 BAGNELL'S SUB'D.
 PART OF BLOCK 15
 HOYT'S ADD.

JOHN B. IRVINE, SURVEYOR.
 408 GLOBE BLDG.

ST. PAUL, MINN.

MARCH 8-1916.

Scale 20 ft. per inch.

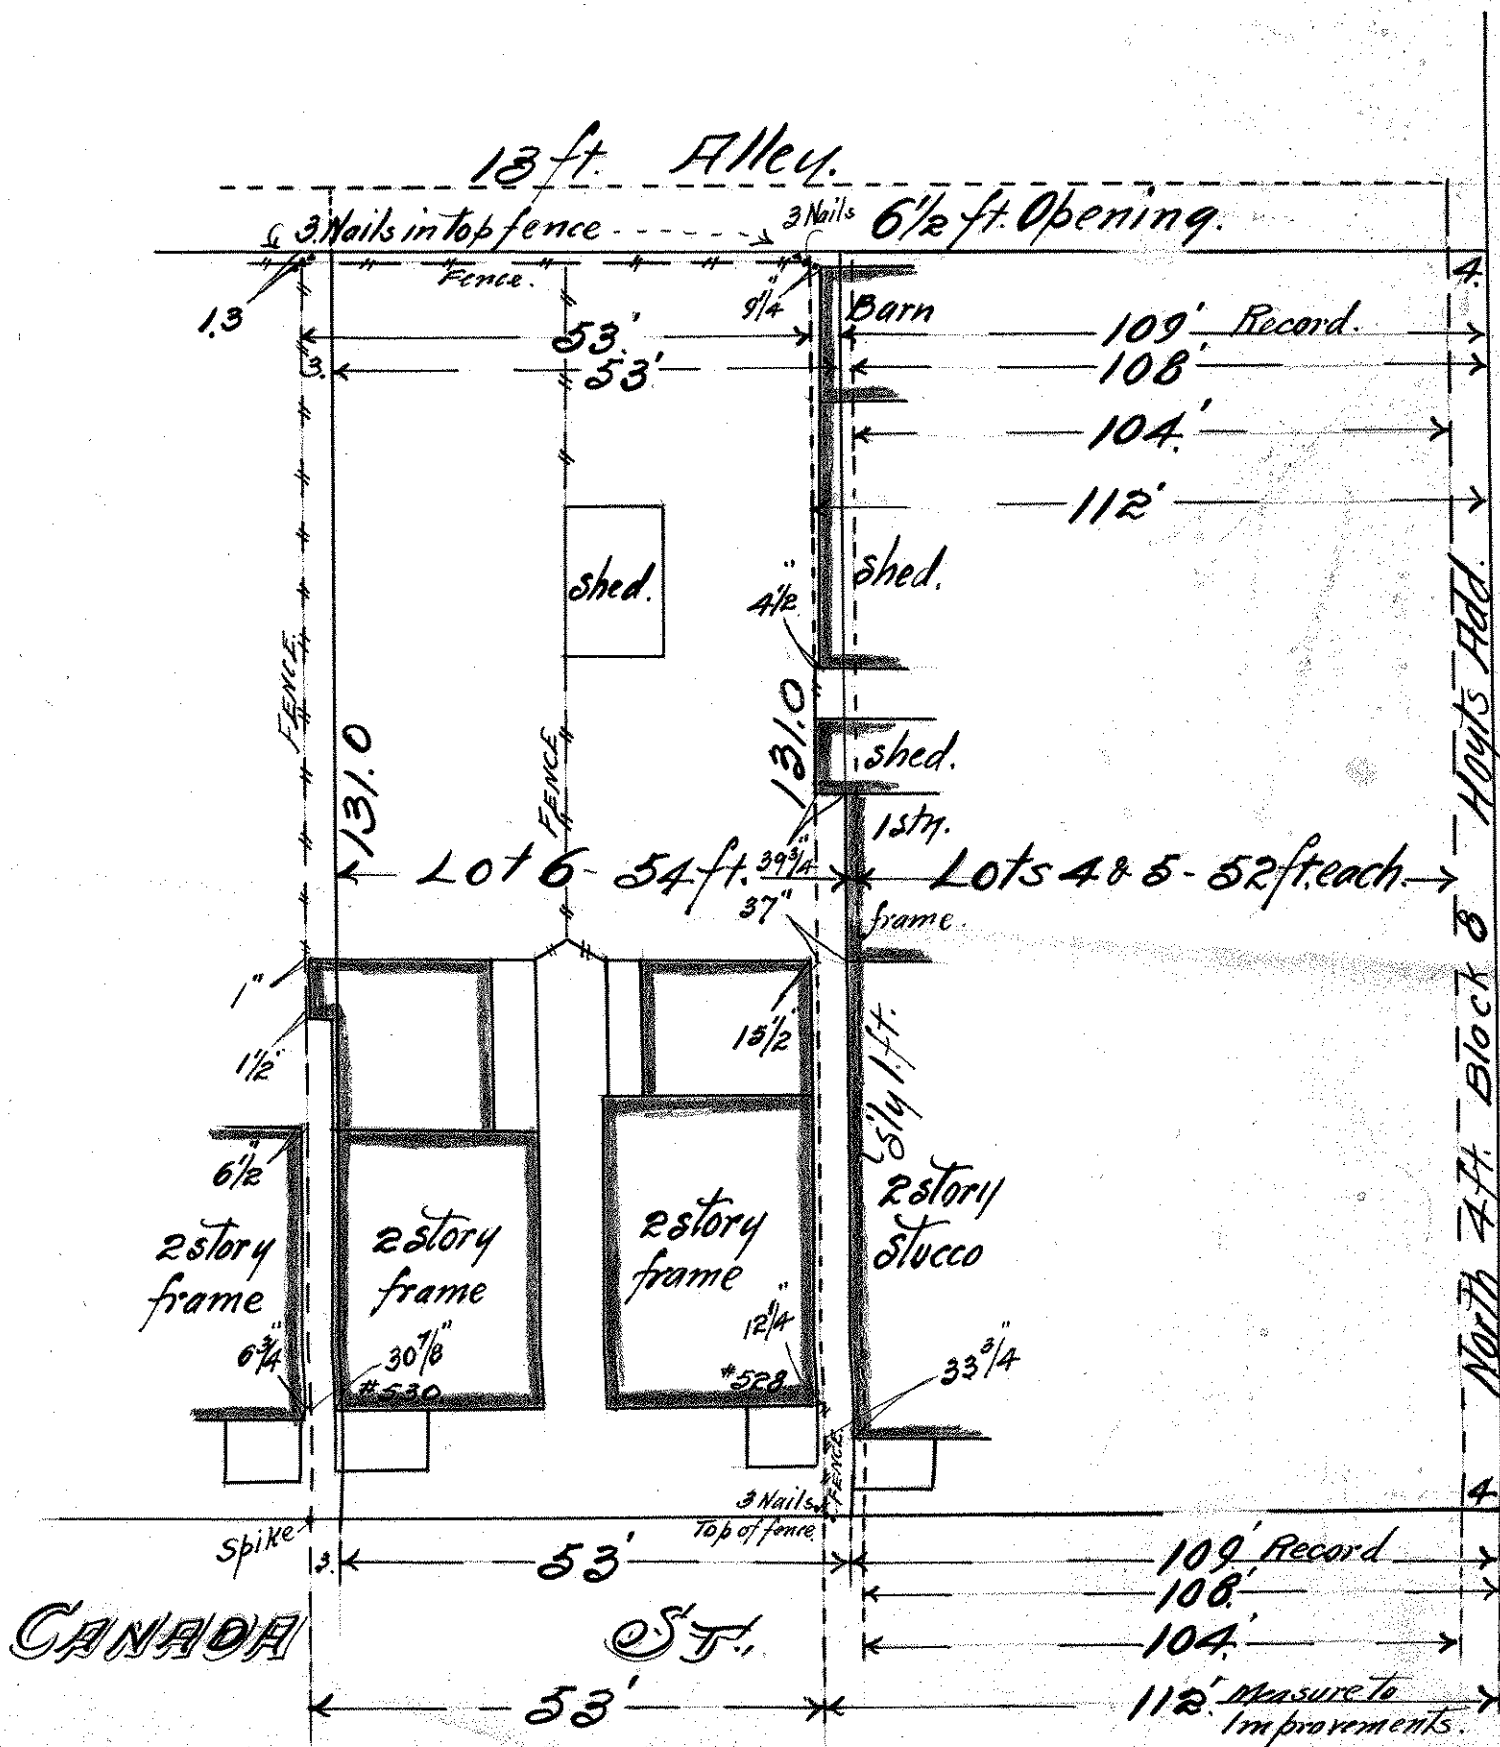

10th St. Opening 50 ft. see H.H. Deeds. Page 146.