


EAST 60ft of LOT 4 &  
4ft STRIP SOUTHERLY  
THEREOF

BAGNELL & M<sup>o</sup>GRONNEN'S  
SUB. OF PART OF BLOCK 15  
HOYT'S ADD.

JOHN B. IRVINE SURVEYOR.  
408. GLOBE BLD'G.  
ST PAUL, MINN.  
JUNE 30-09  
SCALE 20ft per inch.

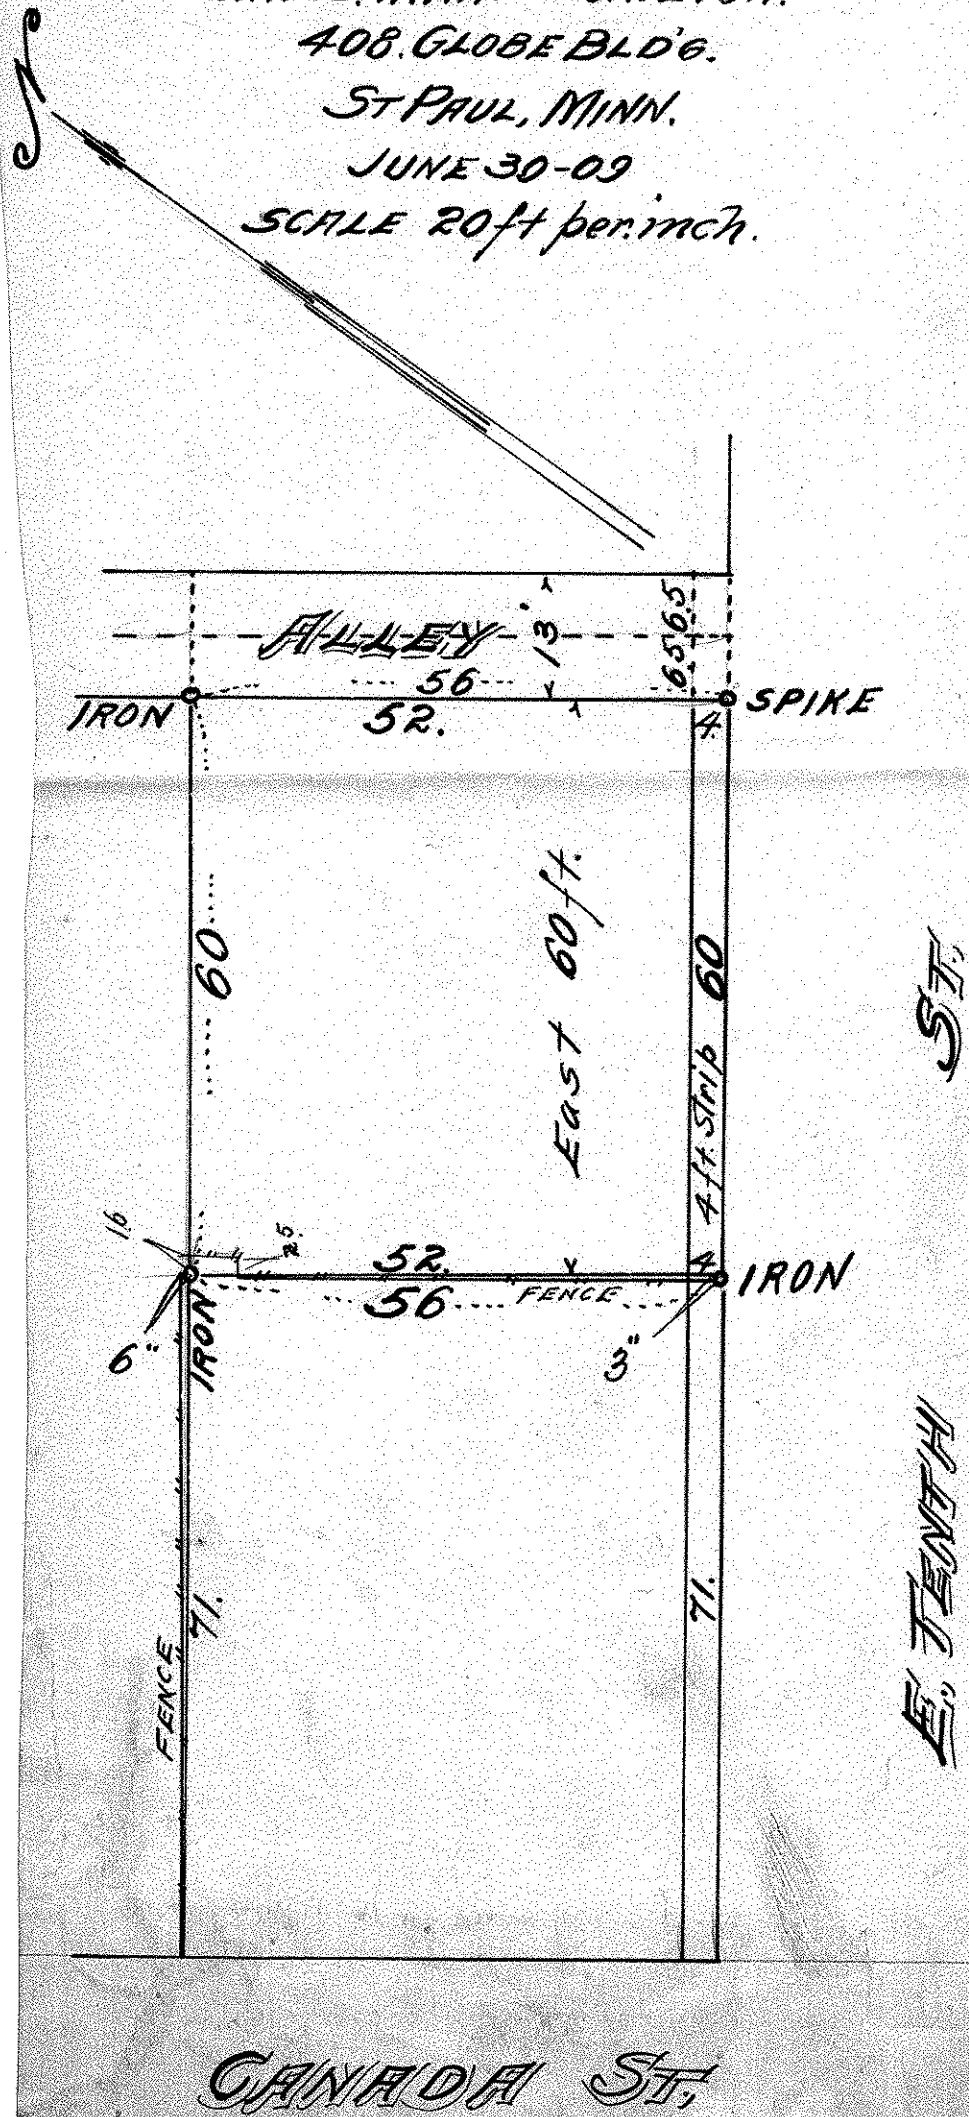

CANADA ST.