

SW 25 29 22

FROM THE OFFICE OF

CHARLES O. GEORGI COMPANY

2215 West County Road B

Saint Paul, Minnesota 55113

REGISTERED CIVIL ENGINEER AND LAND SURVEYOR

Certificate of Survey

I Hereby Certify that this plat shows a survey made by me of the property described on this plat, and that the corners are correctly placed as shown, and that all locations have been correctly shown.

Surveyed For Tim Maccinan

Date April, 1970

Scale 1"=60'

By Charles O. Georgi
REGISTERED LAND SURVEYOR


Description:

The West 100 feet of lot 8 and 9, Block 9, Bartelmy Acres Second Addition, Ramsey County, Minnesota.

Description:

All of lots 6 and 7, Block 9, Bartelmy Acres Second Addition, except the West 90 feet thereof, Ramsey County, Minnesota.

Description: All of lots 8 and 9, Block 9, Bartelmy Acres Second Addition, except the West 100 feet thereof, and the West 10 feet of lots 6 and 7, Block 9, Bartelmy Acres Second Addition, Ramsey County, Minnesota.

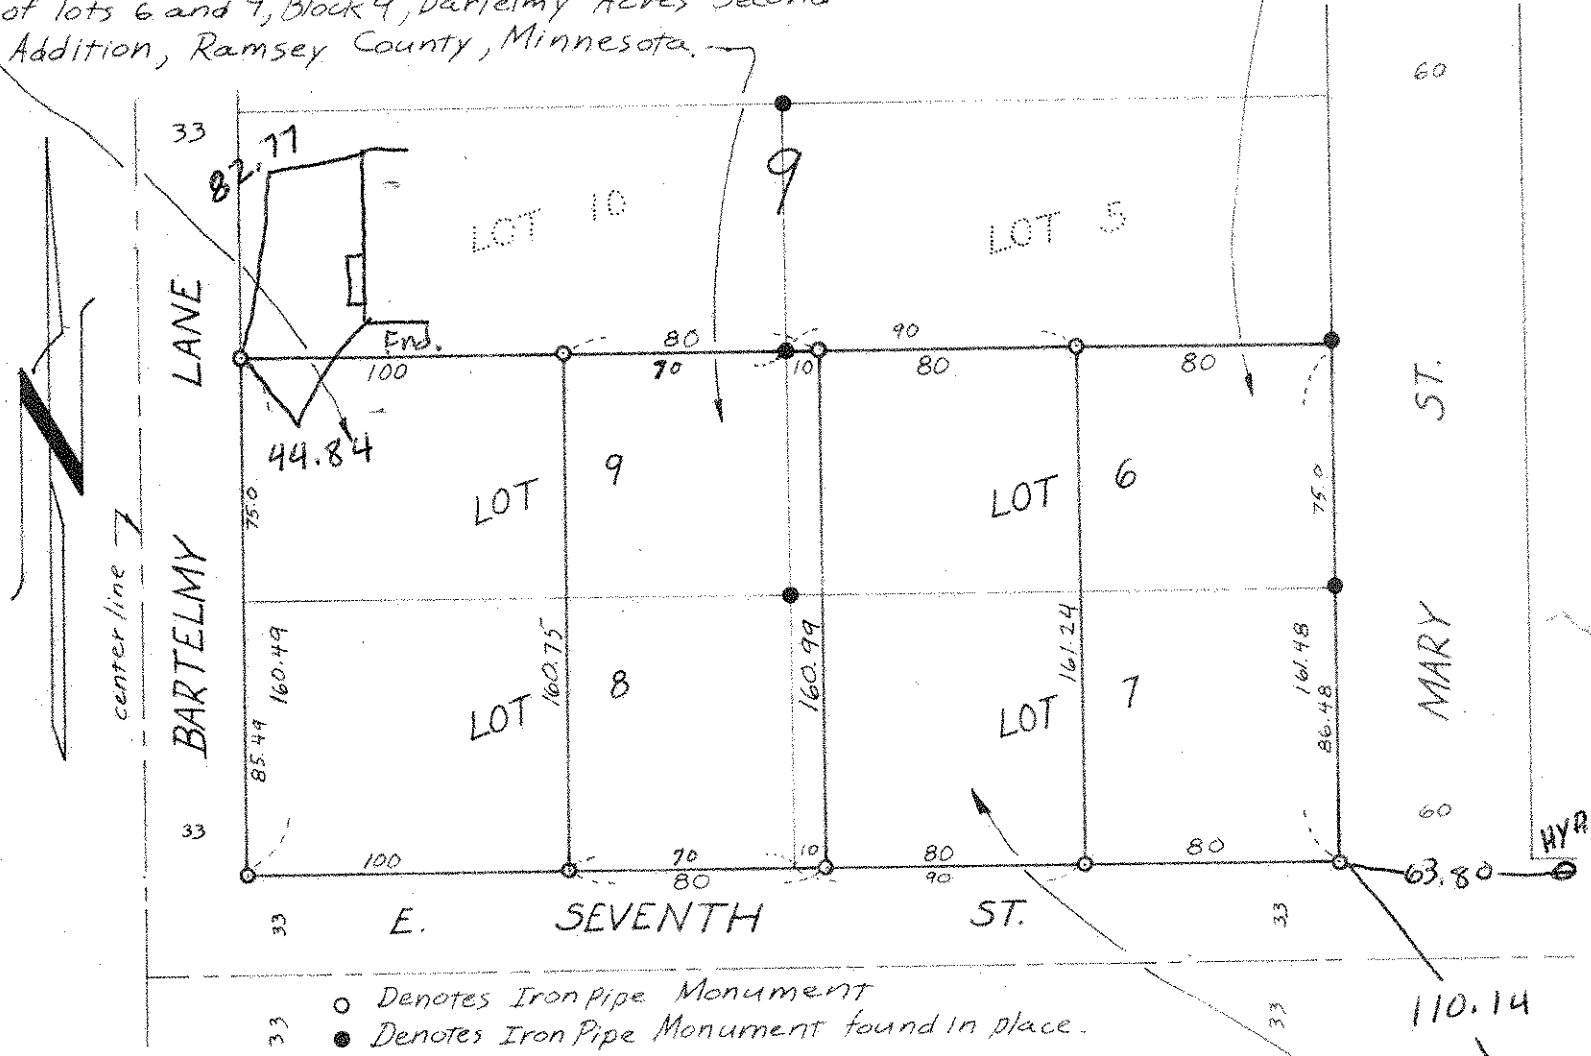

Description: The East 80 feet of the West 90 feet of lots 6 and 7, Block 9, Bartelmy Acres Second Addition, Ramsey County, Minnesota.

#2472 Fred