G.V.BACON'S ADD.

SCALE: 200 FT TO THE INCH.
• INDICATES IRON BOLT.
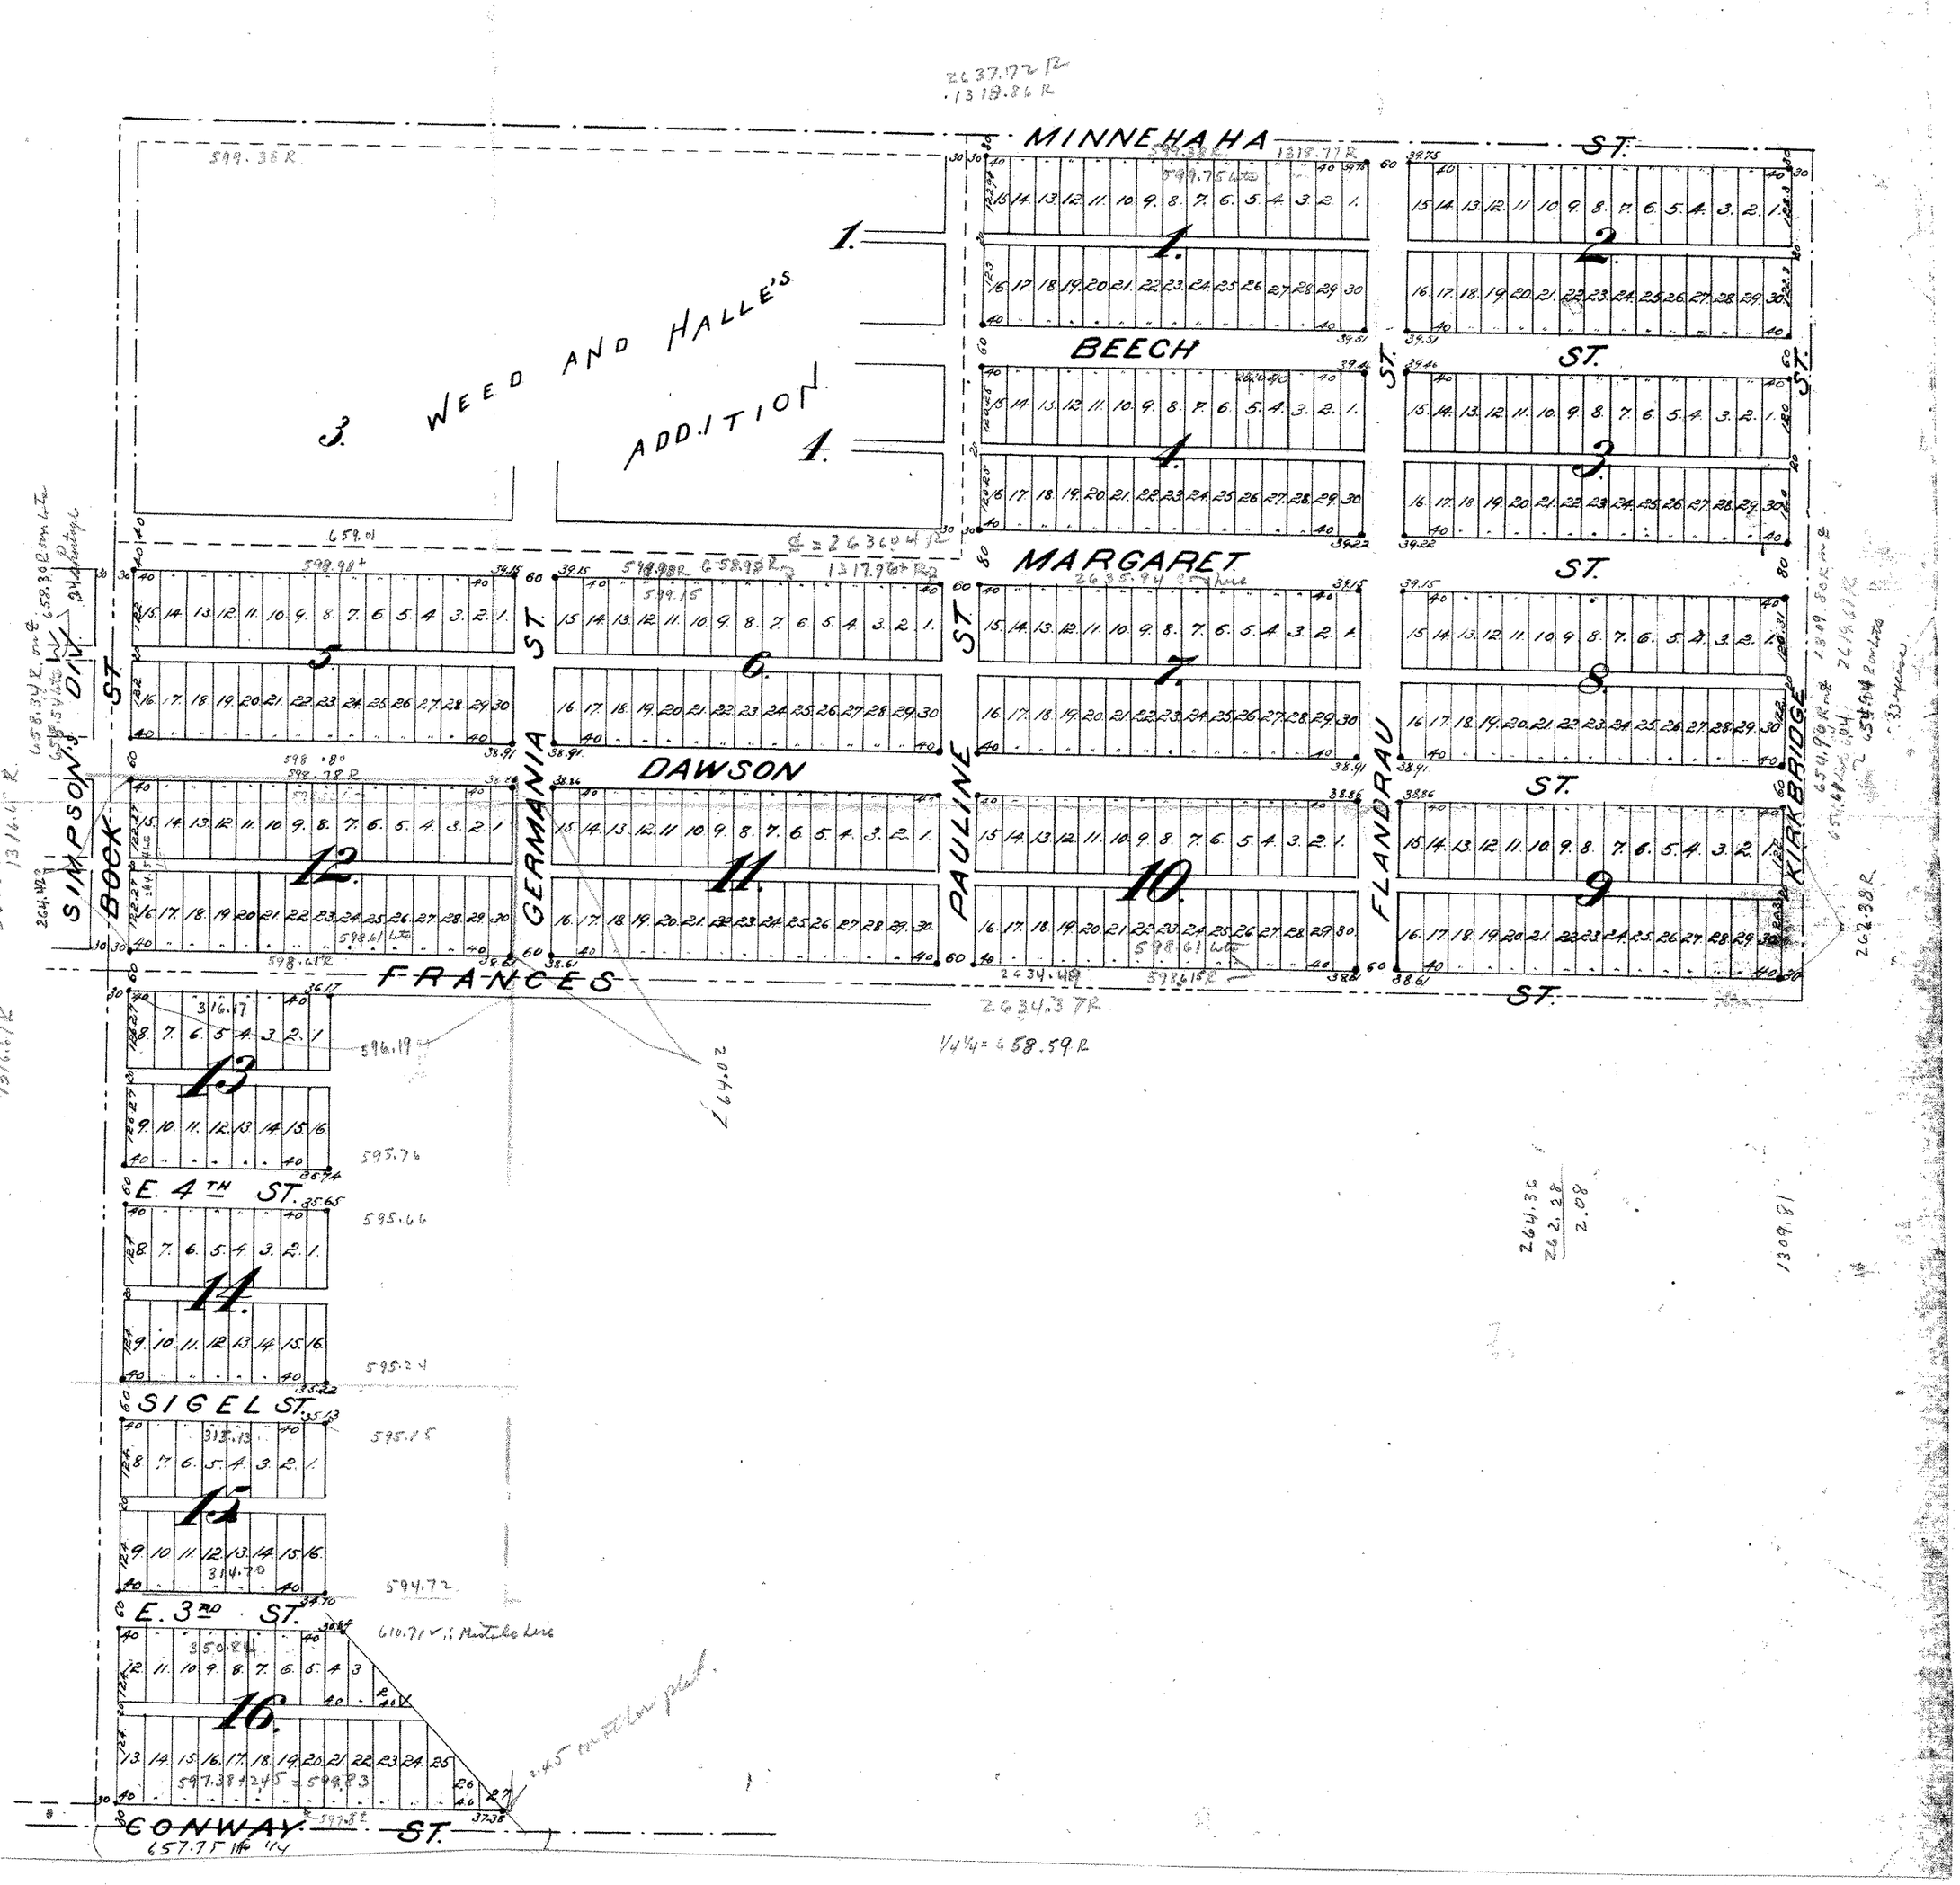
D. L. Curtice Surv. 1886.