


OKford


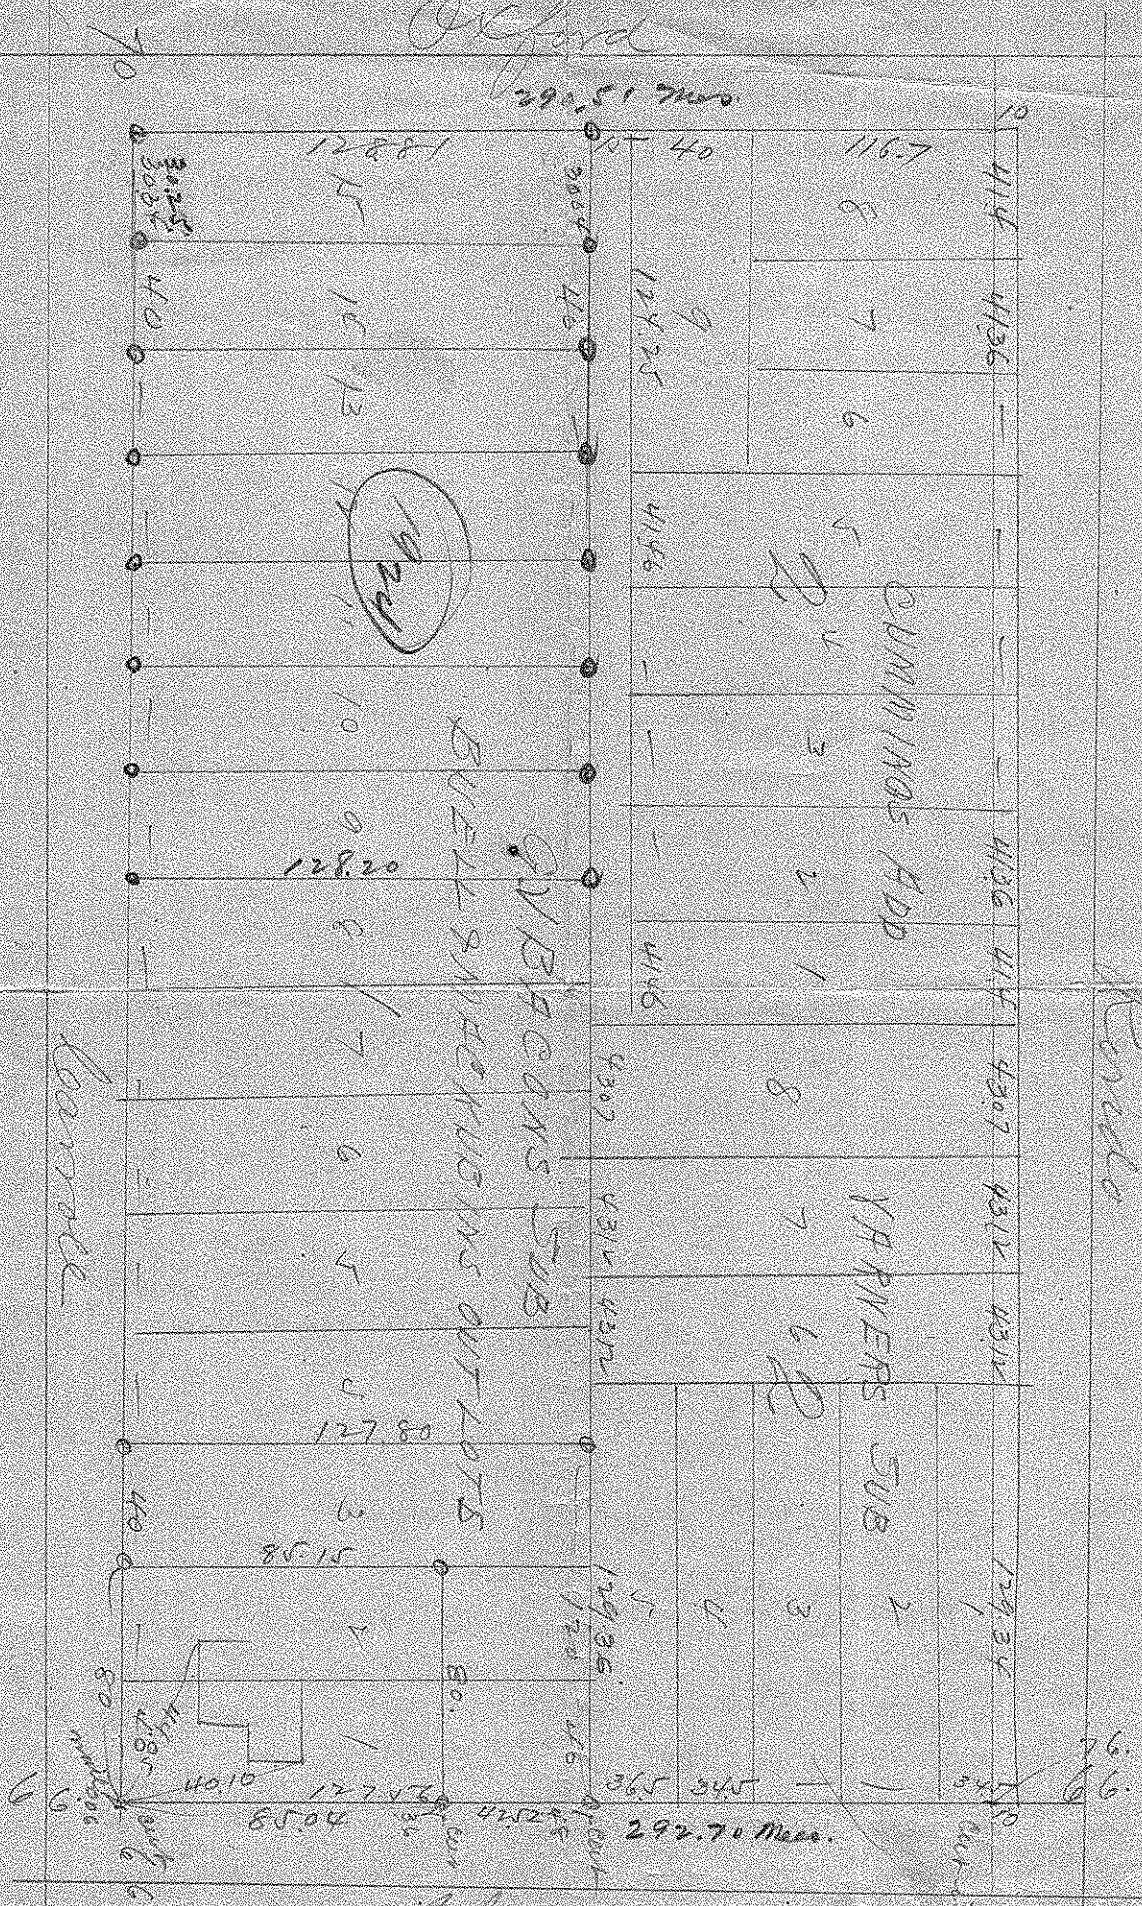

Rondo




26.66

50' wide

50' wide

Bo.

85.04

4010

4180

50' wide

4224

4124

4124

