


EDGEMONT ST.

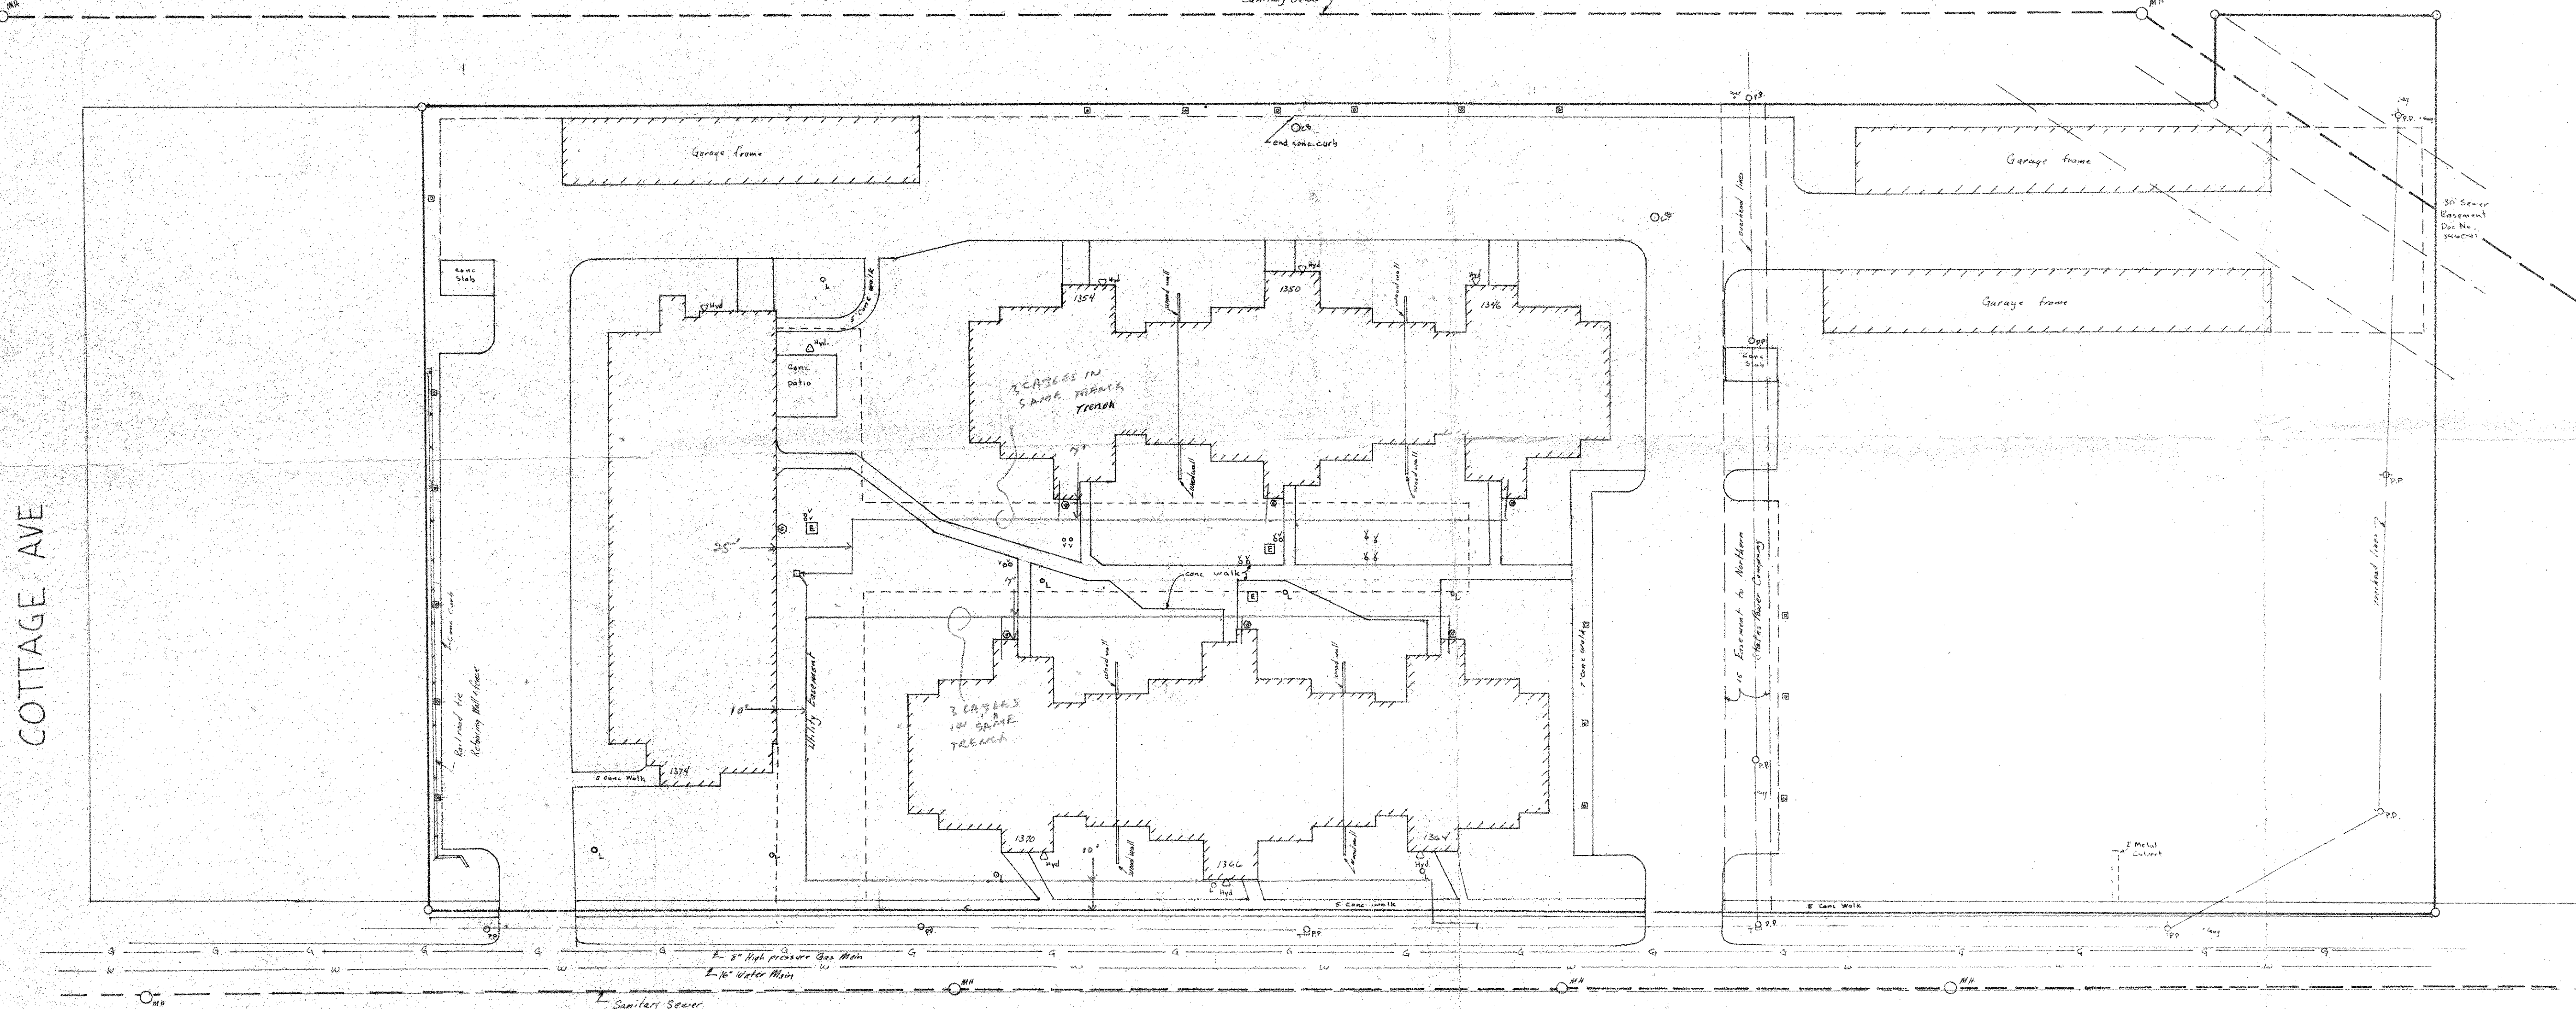

WESTMINSTER STREET

COTTAGE AVE

MINIMUM BATH 30" EXCEPT WHERE TELEPHONE CROSSER GAS AND ELECTRIC MINIMUM OF 10" CLEARANCE.

LOCATIONS MAY NOT BE EXACT. DIAL OPERATOR AND ASK FOR ZENITH 2345 BEFORE DIGGING.

- Denotes iron pipe monument
- _M Denotes Manhole
- _C Denotes Catch basin
- _P Denotes power pole
- ⊠ Denotes Transformer
- ⊙ Denotes Gas Meter
- ⊕ Denotes Water Valve
- ⊠ Denotes Telephone Box
- ⊠_F Denotes Fire Hydrant or Stand pipe
- ⊠ Denotes Elec outlet on post
- ⊠ Denotes Light pole

Half close in 15 to 20 days

Get Certification from F.H.A. & other data. is bldg. loc.

1. Need 6 prints of this when added
2. Need surveyor report.

Have ready plans @ 10:00 AM
Call Sewer - 227-8731

LOCATION MAP

WESTMINSTER PLACE

ST PAUL, MINN

SCALE 1" = 30'

UTILITIES TELEPHONE

KORNER