

SOUTHERLY 26ft. LOT 1 &  
NORTHERLY 14ft. LOT 9

BLOCK 2.

BAZILLE'S ADD.

EXCEPT 12th ST. OPENING.

JOHN B. IRVINE, SURVEYOR.

408 GLOBE BLDG.


ST. PAUL, MINN.

JUNE 11-1917

Scale 50ft. per inch.

SUMMIT AVE.

WABASH ST.

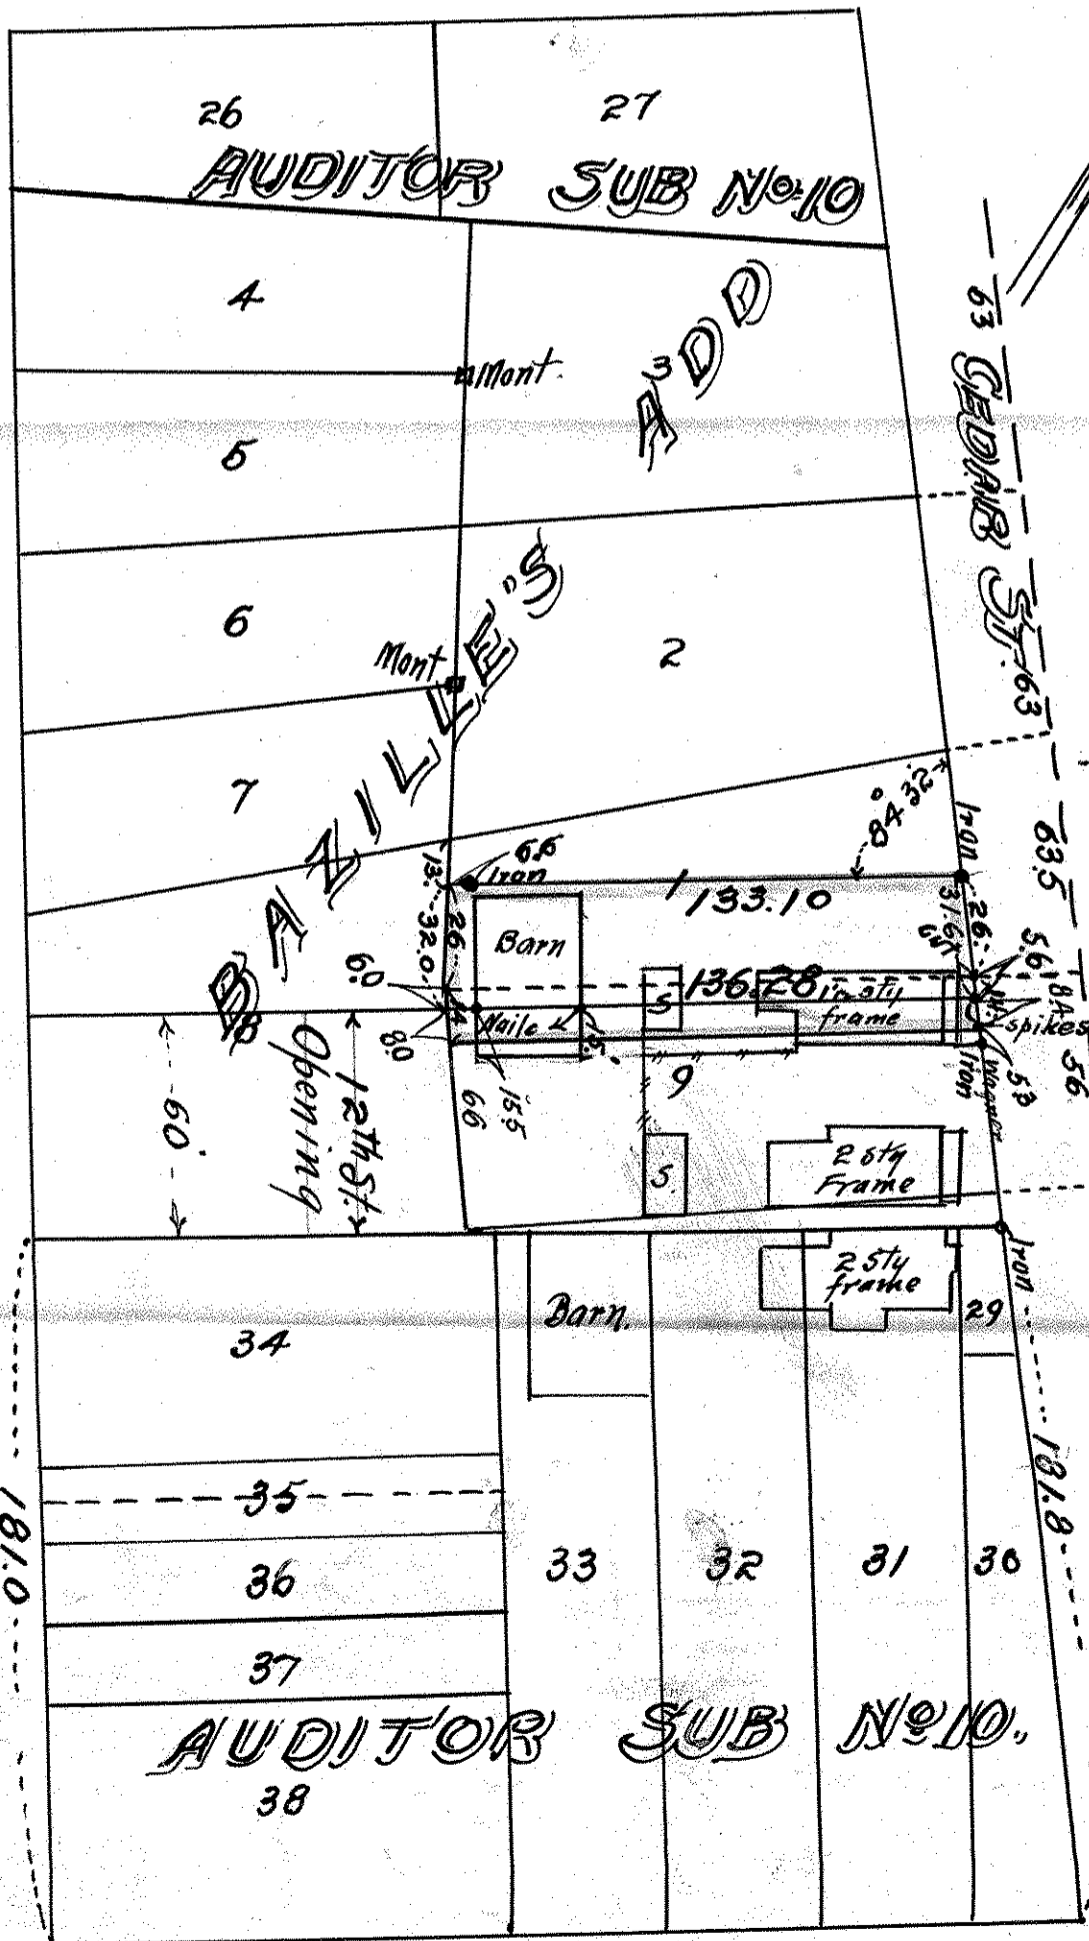

12.  
ST.

COLLEGE AVE.

1-1-02