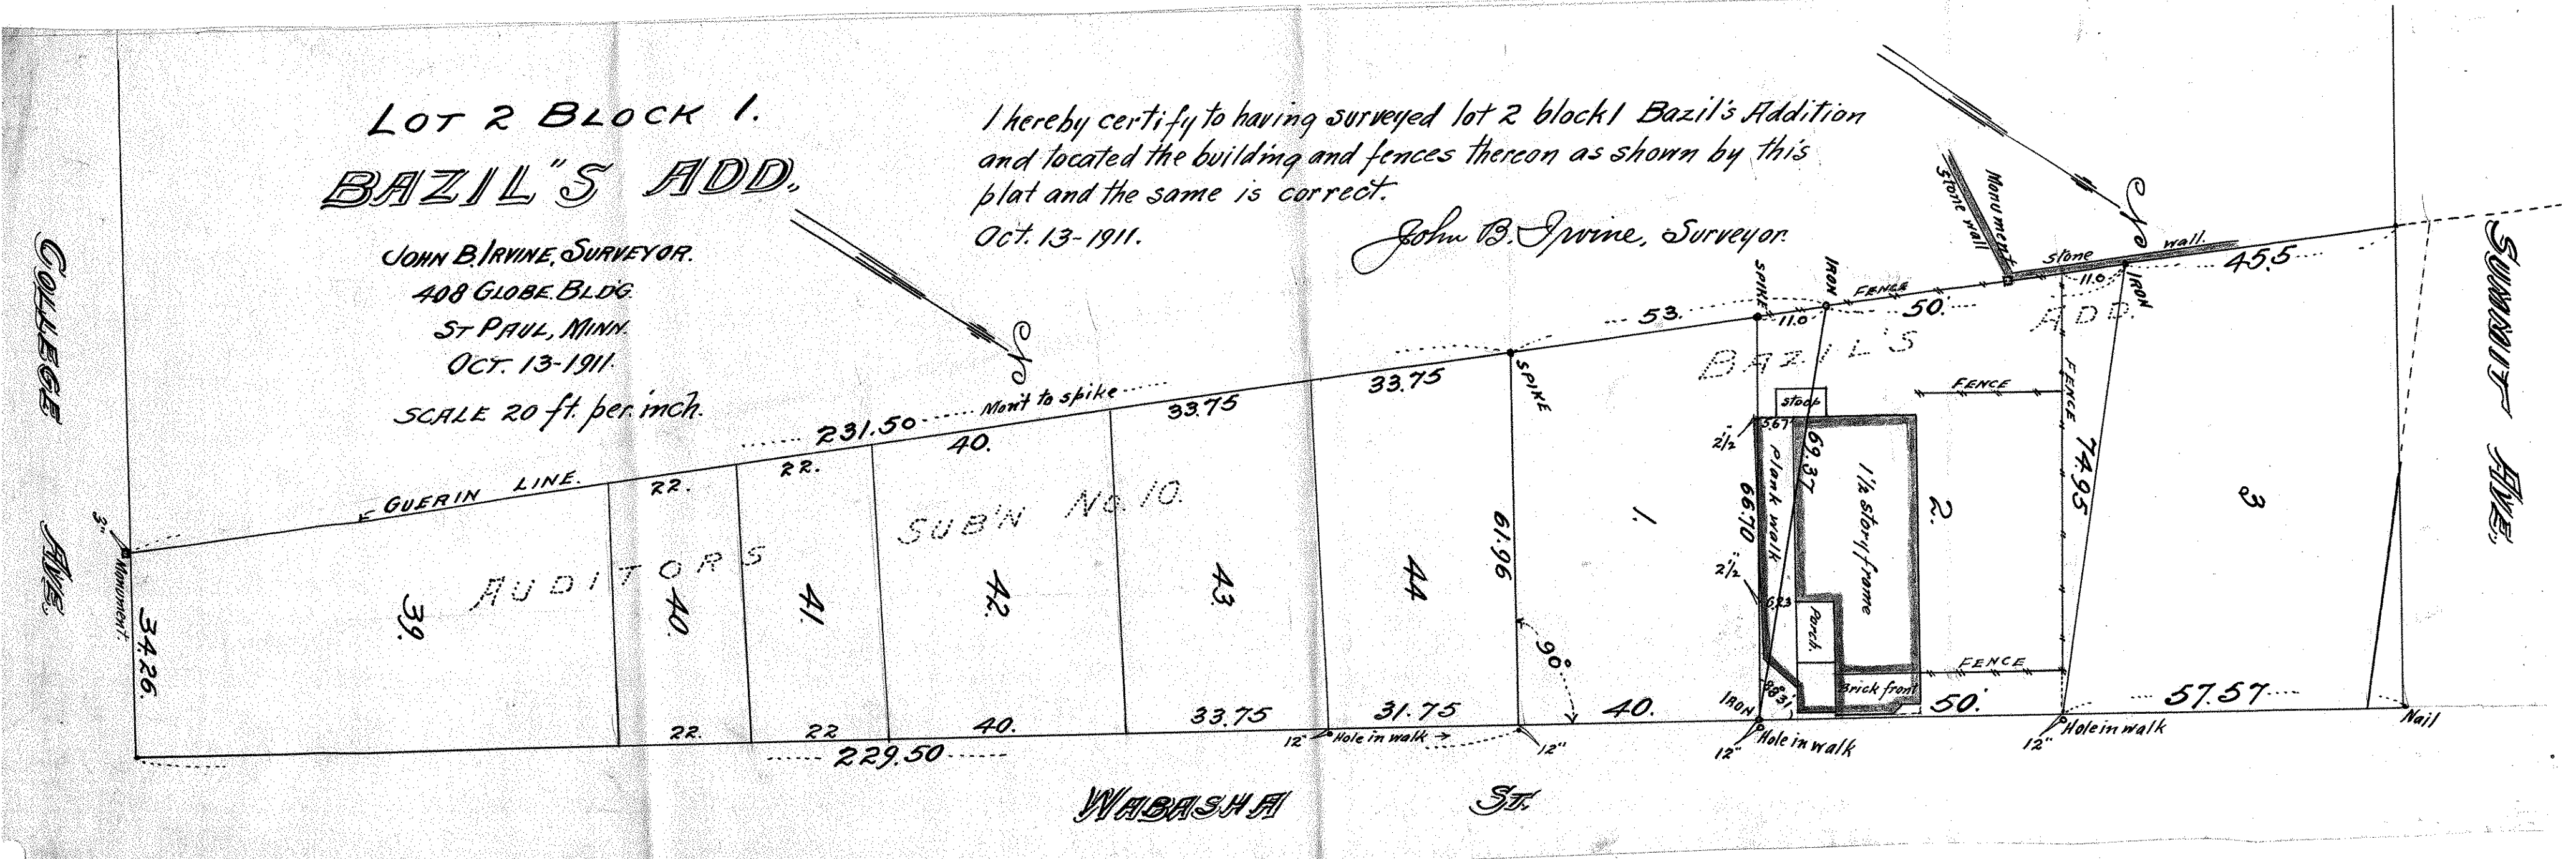
LOT 2 BLOCK 1.
BAZIL"S ADD.
JOHN B. IRVINE, SURVEYOR.
408 GLOBE BLDG.
ST PAUL, MINN.
OCT. 13-1911.
SCALE 20 ft. per inch.
I hereby certify to having surveyed lot 2 block 1 Bazil's Addition and located the building and fences thereon as shown by this plat and the same is correct.
Oct. 13-1911.
John B. Irvine, Surveyor.
COLLEGE AVE.
SUMMIT AVE.
WABASHA ST.
GUERIN LINE.
AUDITORS SUB'N No. 10.
BAZIL'S ADD.
Monument
Stone wall
Stone wall
Monument
Monument
Hole in walk
Hole in walk
Hole in walk
Nail
Spike
Spike
Iron
Iron
Iron
Fence
Fence
Fence
Fence
Stoop
Plank walk
Porch
1½ story frame
Brick front
231.50
229.50
Mon't to spike
90°
34.26
39.
40.
41.
42.
43.
44
1.
2.
3
22.
22.
22.
22
40.
40.
40.
33.75
33.75
33.75
31.75
61.96
53.
50.
50.
45.5
57.57
74.95
66.70
69.37
11.0
11.0
5.67
6.23
88.31
2½
2½
12"
12"
12"
12"
3"