


LOT 1 BLOCK 1.
 BAZILLE'S ADD.
 JOHN B. IRVINE, SURVEYOR.
 285 MACKUBIN ST
 ST. PAUL, MINN
 Nov 25-1918.
 Scale. 10 ft. per inch.

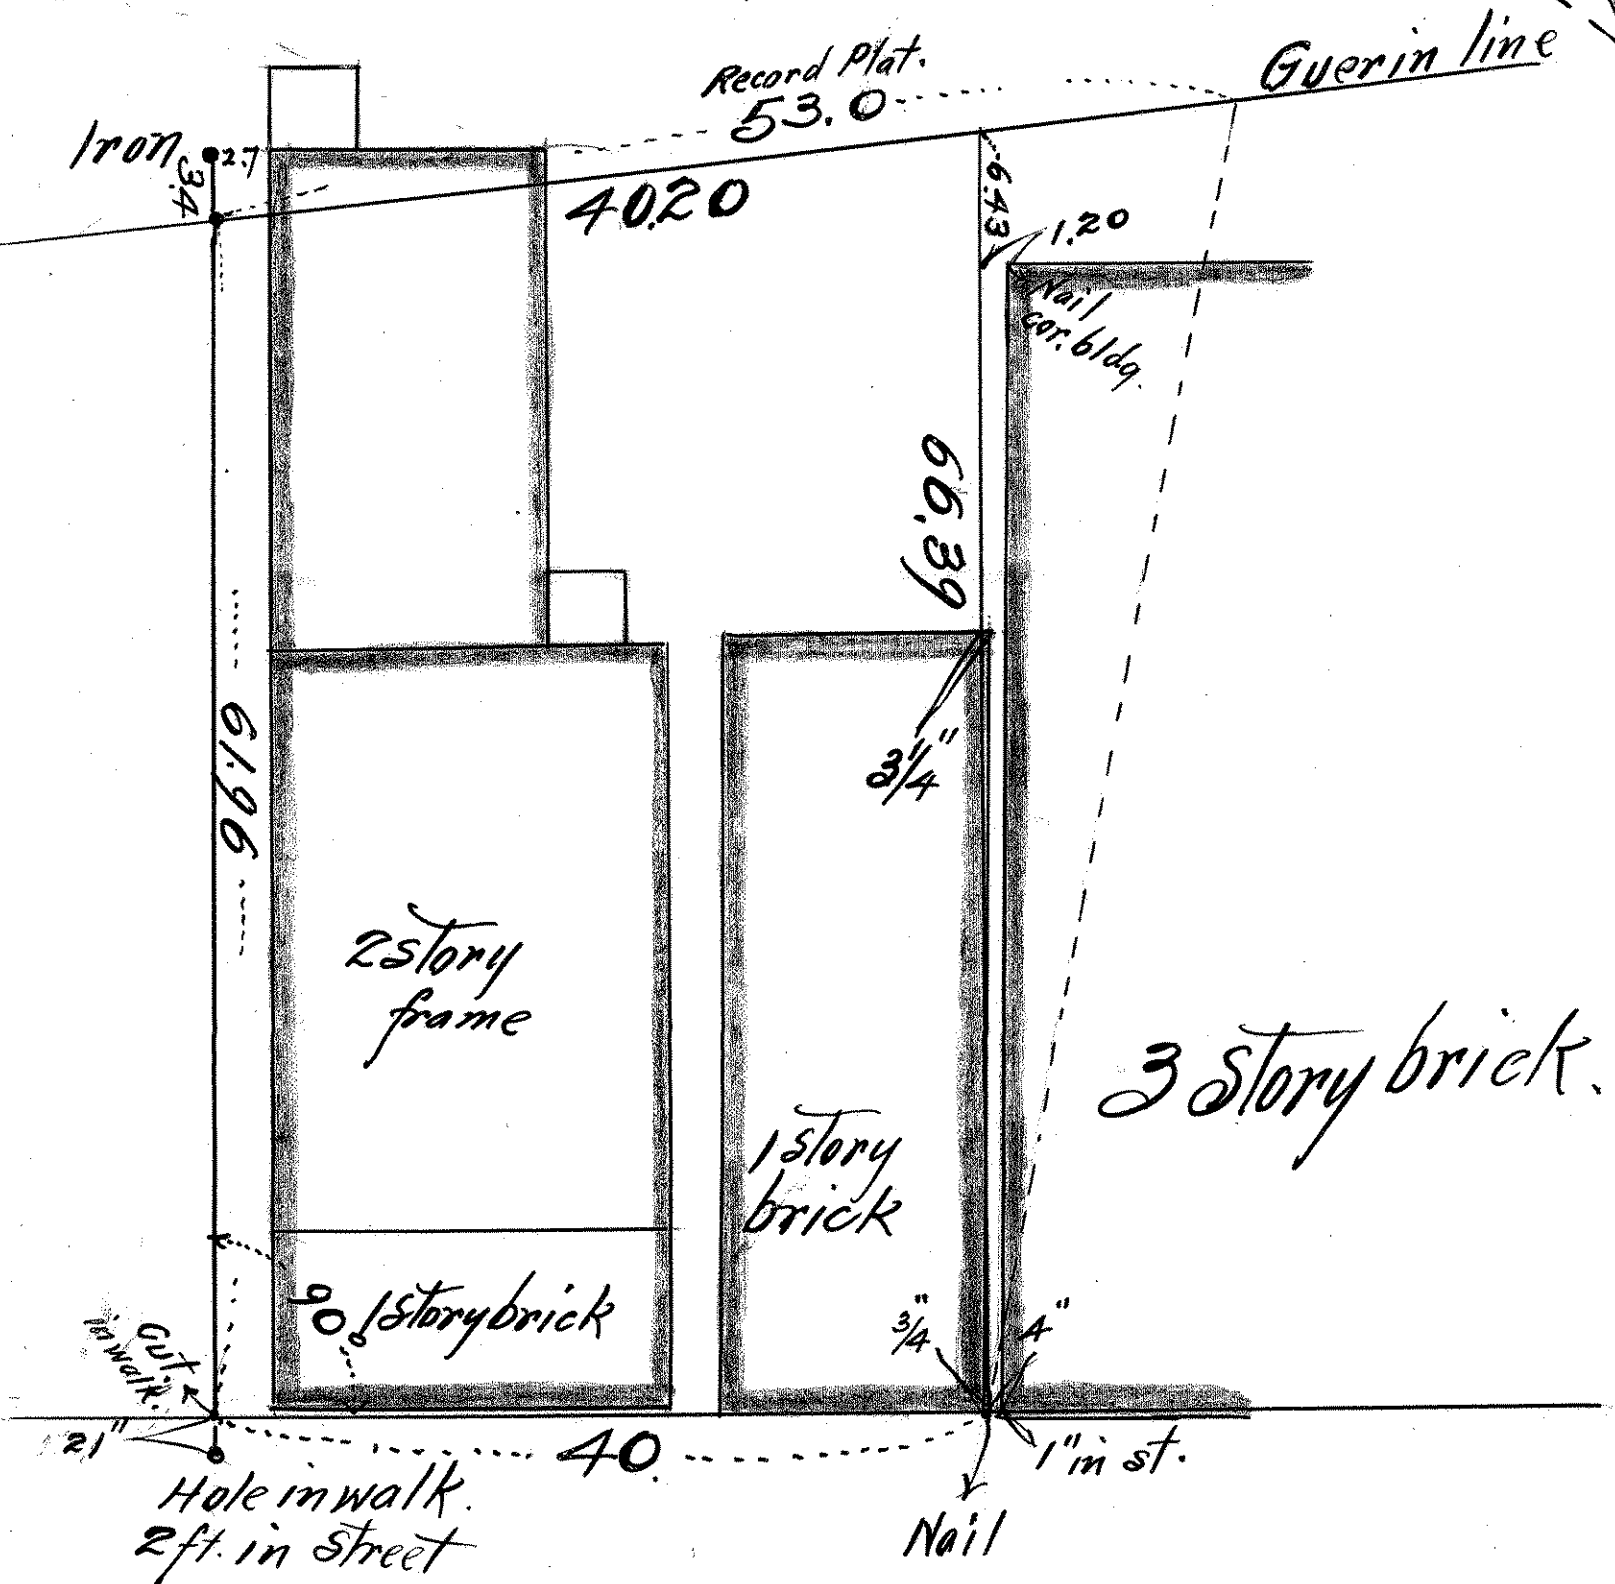

WABASH ST.