SK 8 29 22

Certificate of Survey

From the office of

GEORGI- SCHMIDT & ASSOC. INC.

3092 No. Lexington Ave., Roseville, Mn. 55113

LAND SURVEYING

483-4408

I Hereby Certify that this plat shows a survey made by me of the property described on this plat, and that the corners are correctly placed as shown, and that all locations have been correctly shown.

Job Number: 681

Surveyed For J. BARTEL

Date July 1980

Scale 1"=60'

By Donald W. Schmidt
REGISTERED LAND SURVEYOR

Description:

LOT 13 BLOCK 1
OUCHARME GERVAIS VIEW PARK
RAMSEY COUNTY, MN.

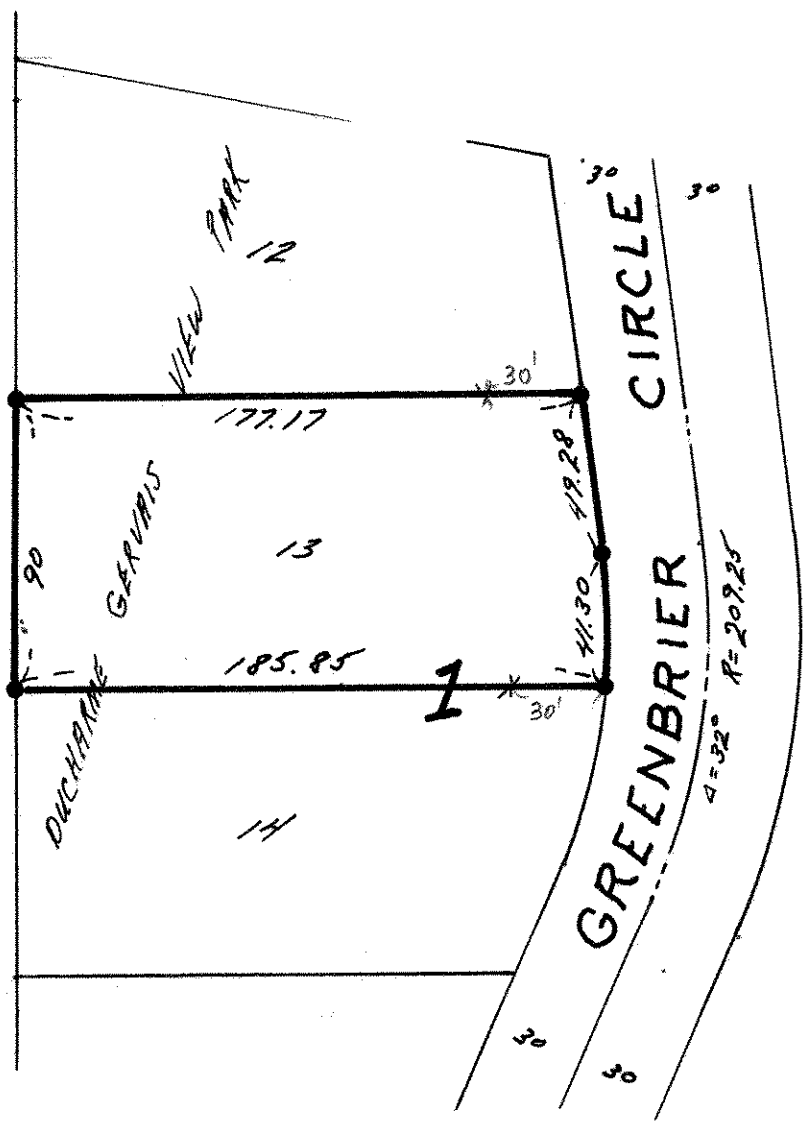

● denotes IRON MONUMENT found

x Lathe place