SW 26 29 22

Certificate of Survey

From the office of

GEORGI- SCHMIDT & ASSOC. INC.

3092 No. Lexington Ave., Roseville, Mn. 55113

LAND SURVEYING

483-4408

I Hereby Certify that this plat shows a survey made by me of the property described on this plat, and that the corners are correctly placed as shown, and that all locations have been correctly shown.

Job Number: 145

Surveyed For Hughes Const.

Date October 1978

Scale 1"=30'

By Donald W Schmidt

REGISTERED LAND SURVEYOR

Description:

Lot 12, Block 15, Beaver Lake Heights

Ramsey County, Minnesota

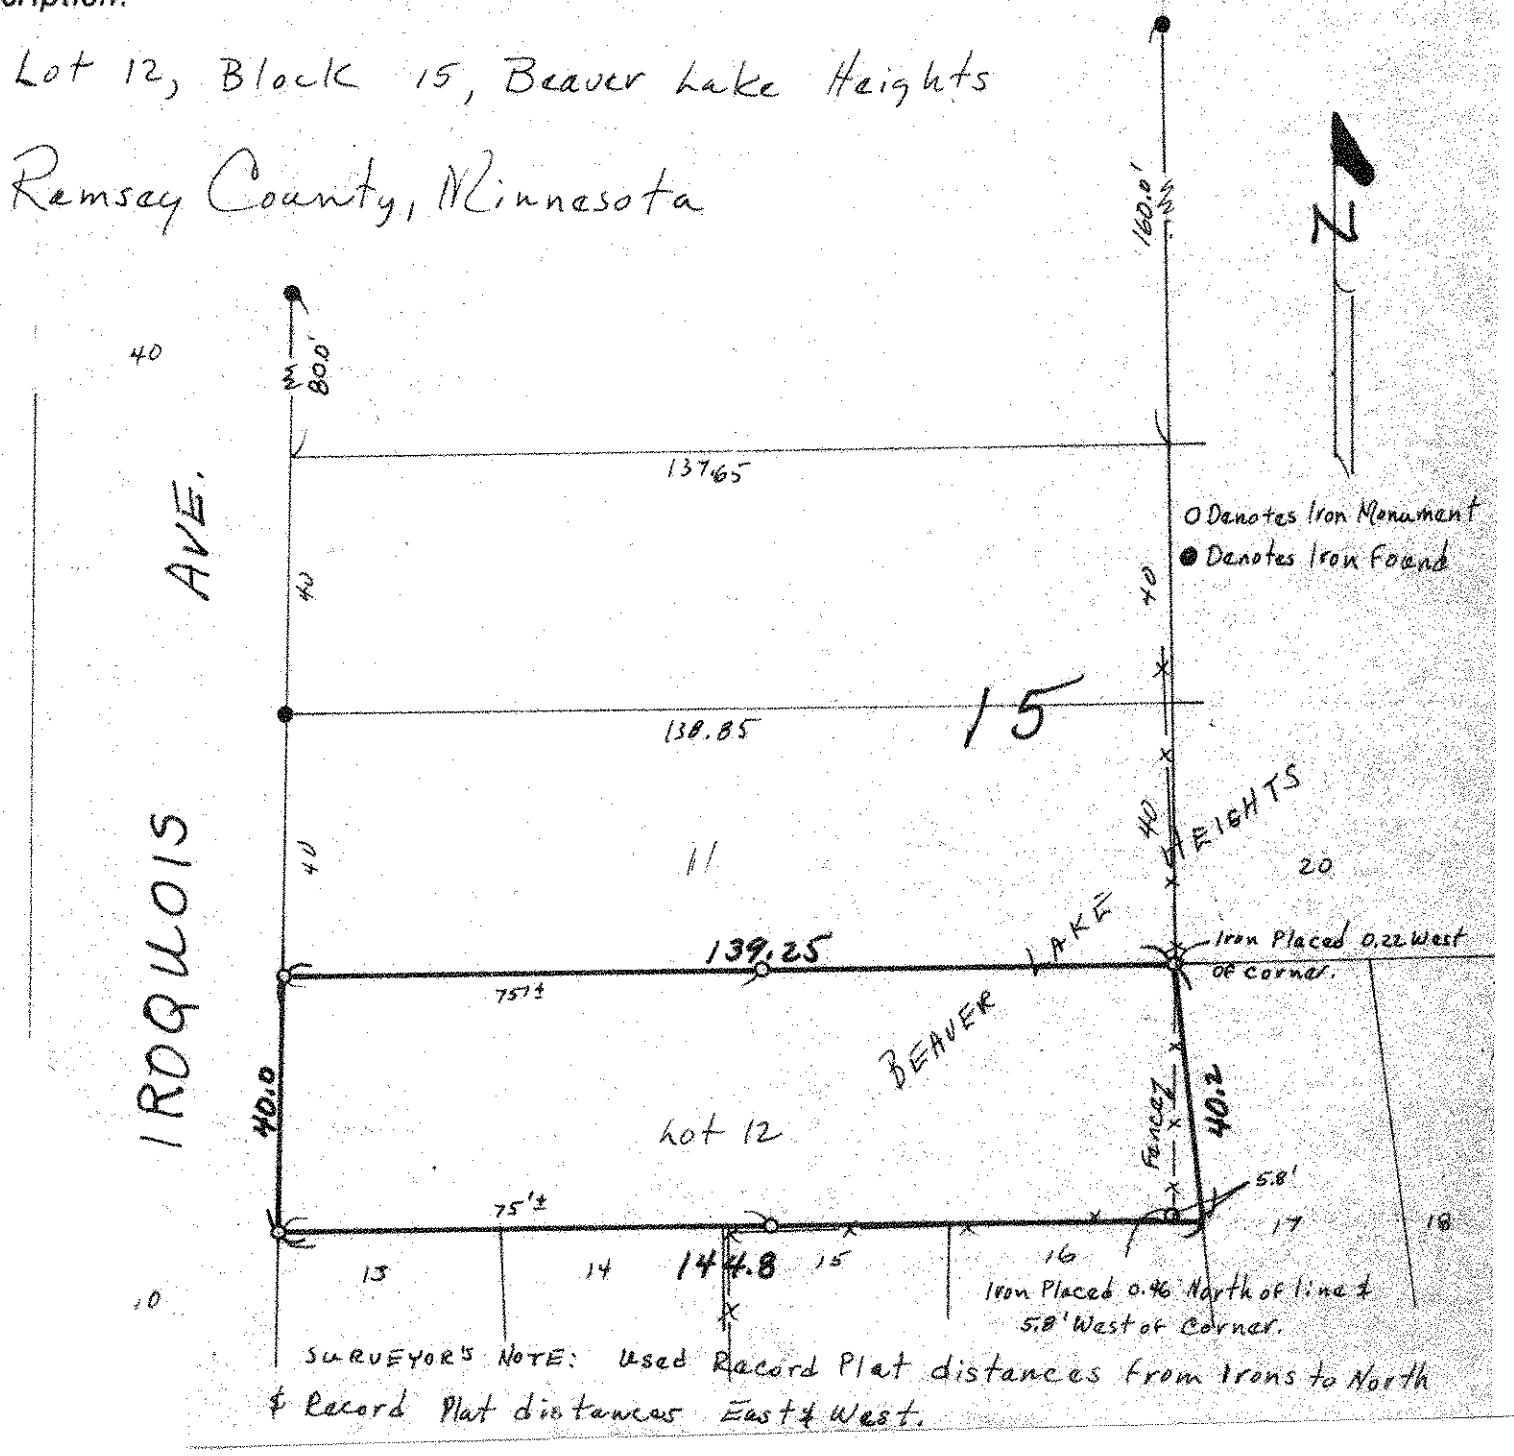

SURVEYOR'S NOTE: Used Record Plat distances from Irons to North & Record Plat distances East & West.