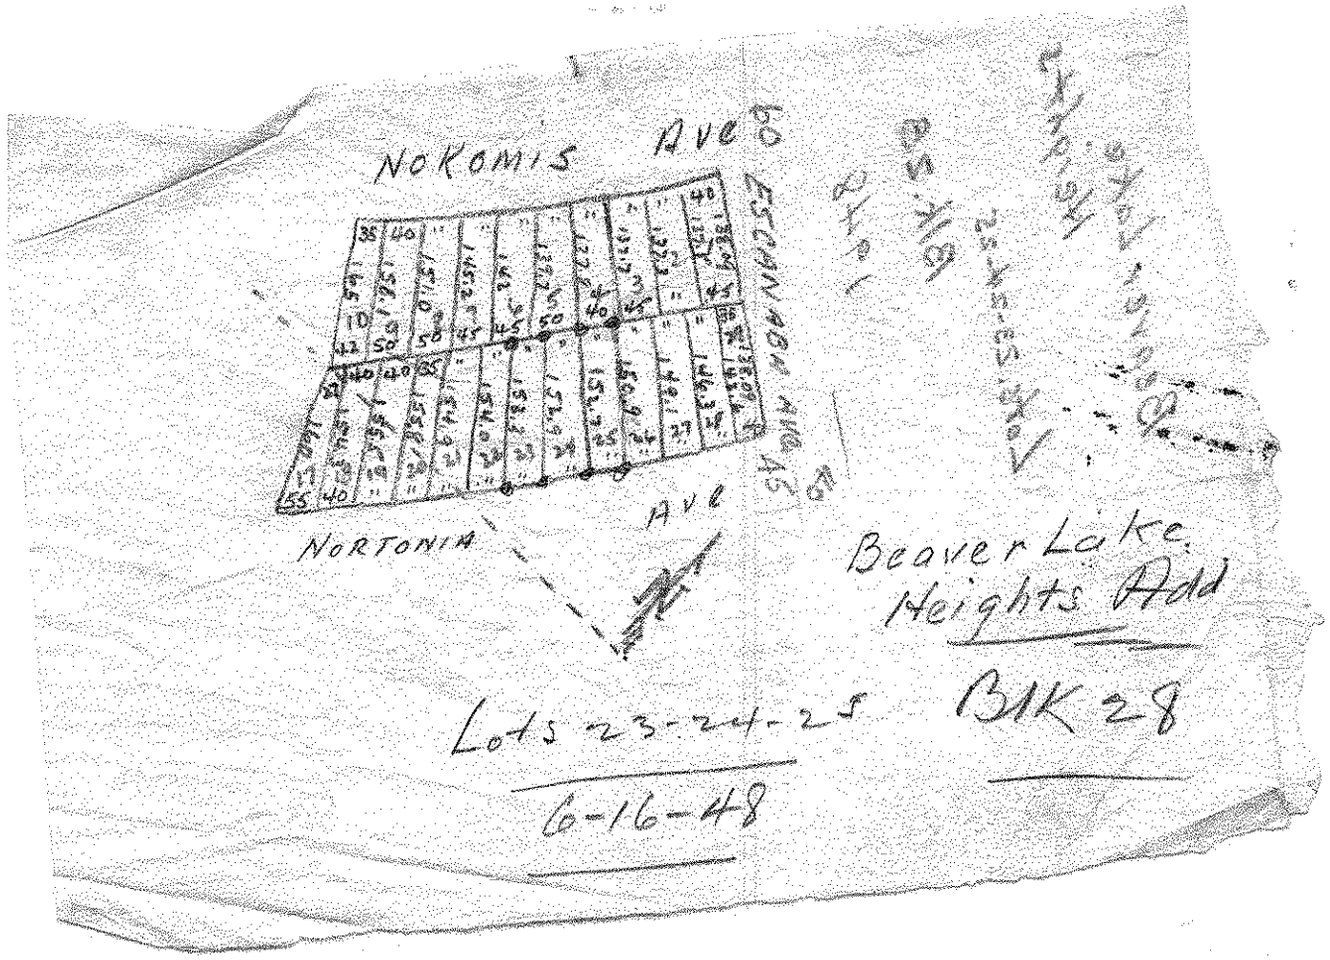
NOKOMIS AVE S
NORTONIA AVE S
Beaver Lake Heights Add
Lots 23-24-25 BLK 28
6-16-48