FROM THE OFFICE OF

Certificate of Survey

BARAC CONST.

Description:

CHARLES O. GEORGI COMPANY

2215 West County Road B

Saint Paul 8, Minnesota

REGISTERED CIVIL ENGINEER AND LAND SURVEYOR

I Hereby Certify that this plat shows a building location survey made by me on the property described on this plat, and that all locations, have been correctly shown.


Date Dec. 1963

Scale 1" =

By Soules O Serveyor REGISTERED LAND SURVEYOR

All of Block 2, Brenner Addition No. 2.

NOTE: Buildings under construction and south bldgs most nearly completed.

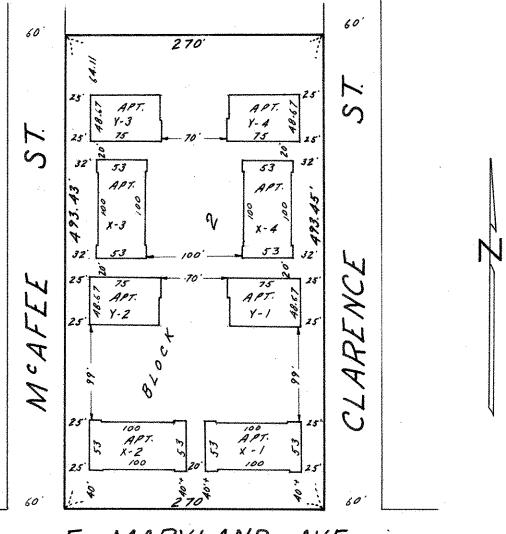

E. MARYLAND AVE.