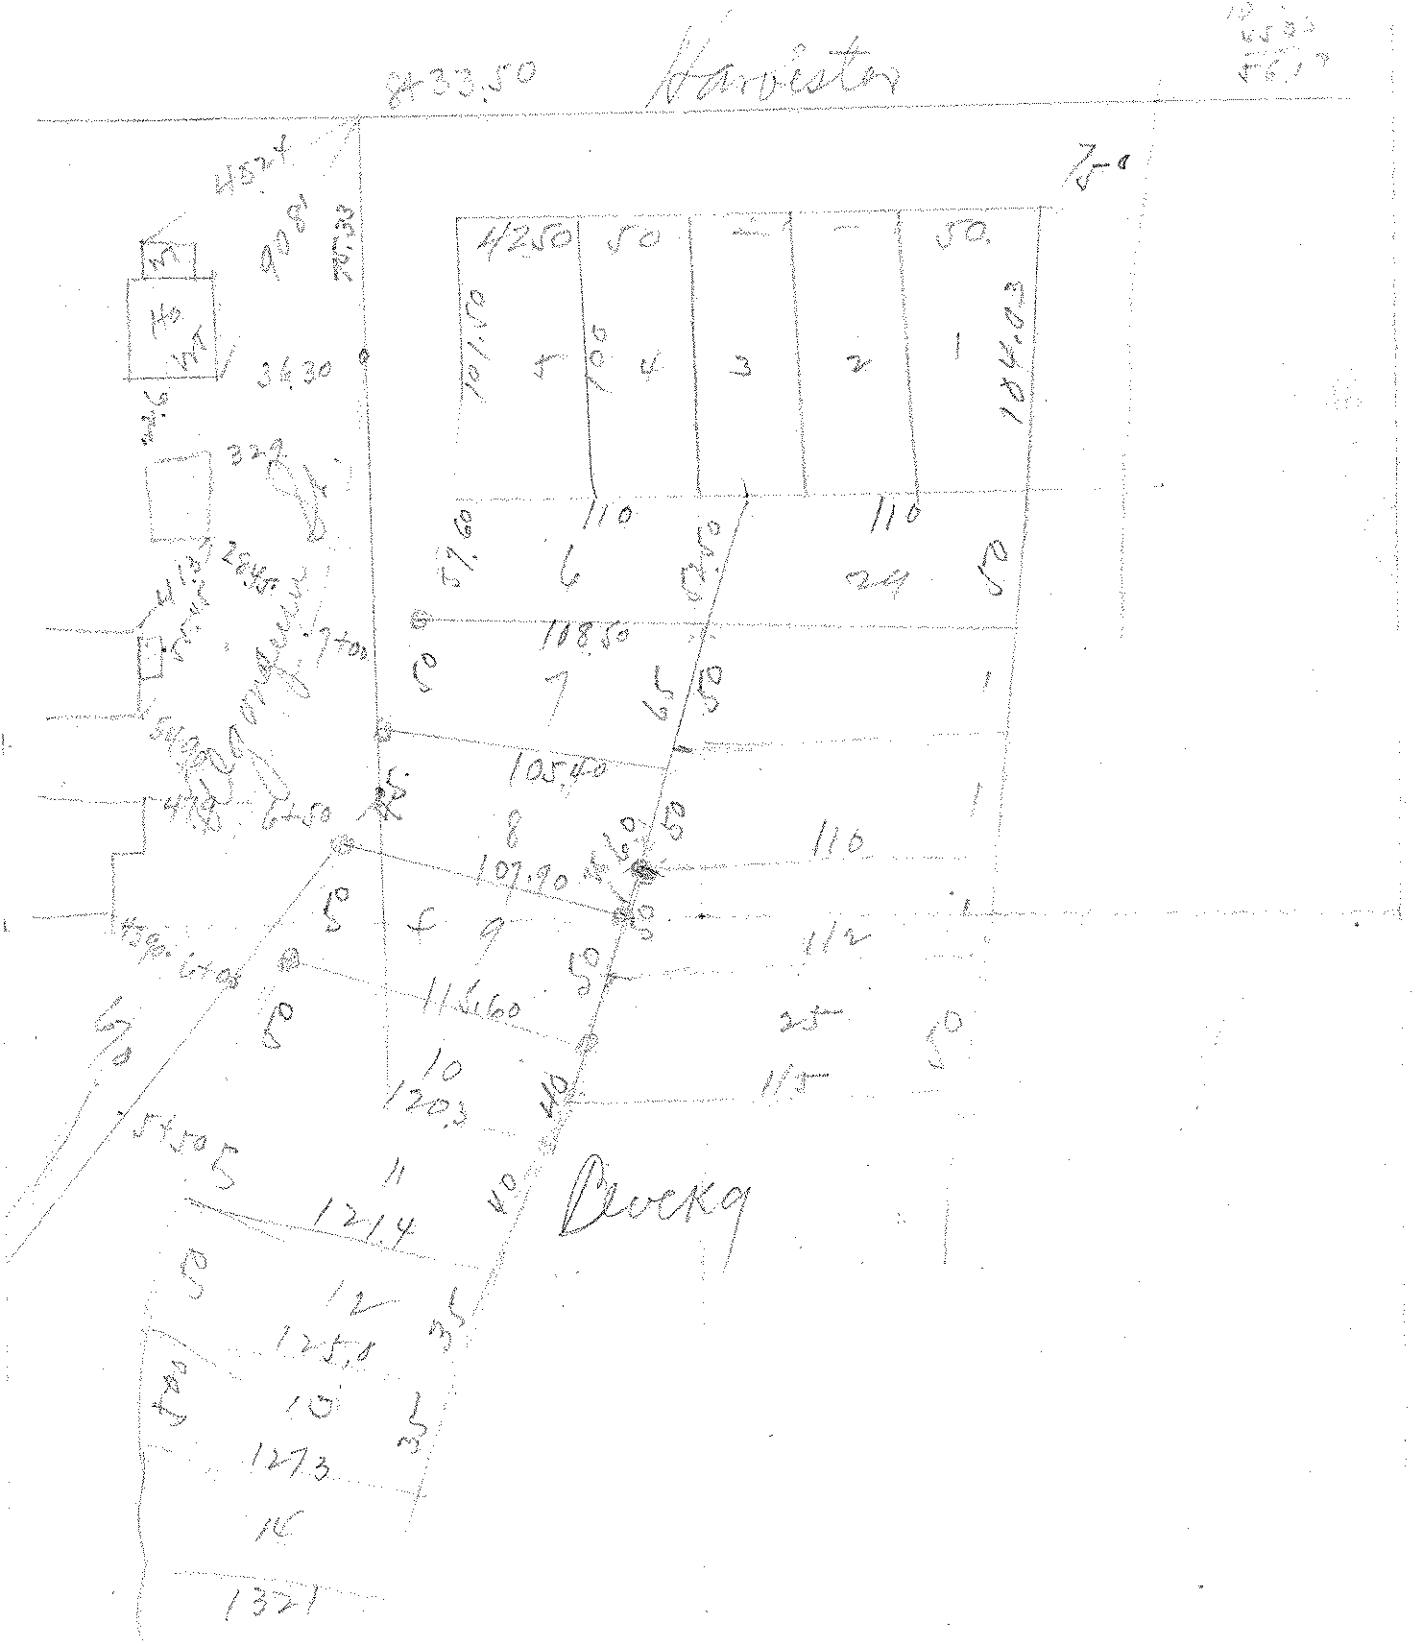
Hardiester
Bucka