SW 23 29 22

Certificate of Survey

From the office of

GEORGI- SCHMIDT & ASSOC. INC.

3092 No. Lexington Ave., Roseville, Mn. 55113

LAND SURVEYING

483-4408

I Hereby Certify that this plat shows a survey made by me of the property described on this plat, and that the corners are correctly placed as shown, and that all locations have been correctly shown.

Job Number: 184

Surveyed For Brothers Realty

Date November 1978

Scale 1"=40'

By Donald W Schmidt

REGISTERED LAND SURVEYOR

Description:

Lot 8, Block 8, Hayden Heights Addition, subject to easement over south 3.0 feet thereof for purposes of sidewalk and maintanence.
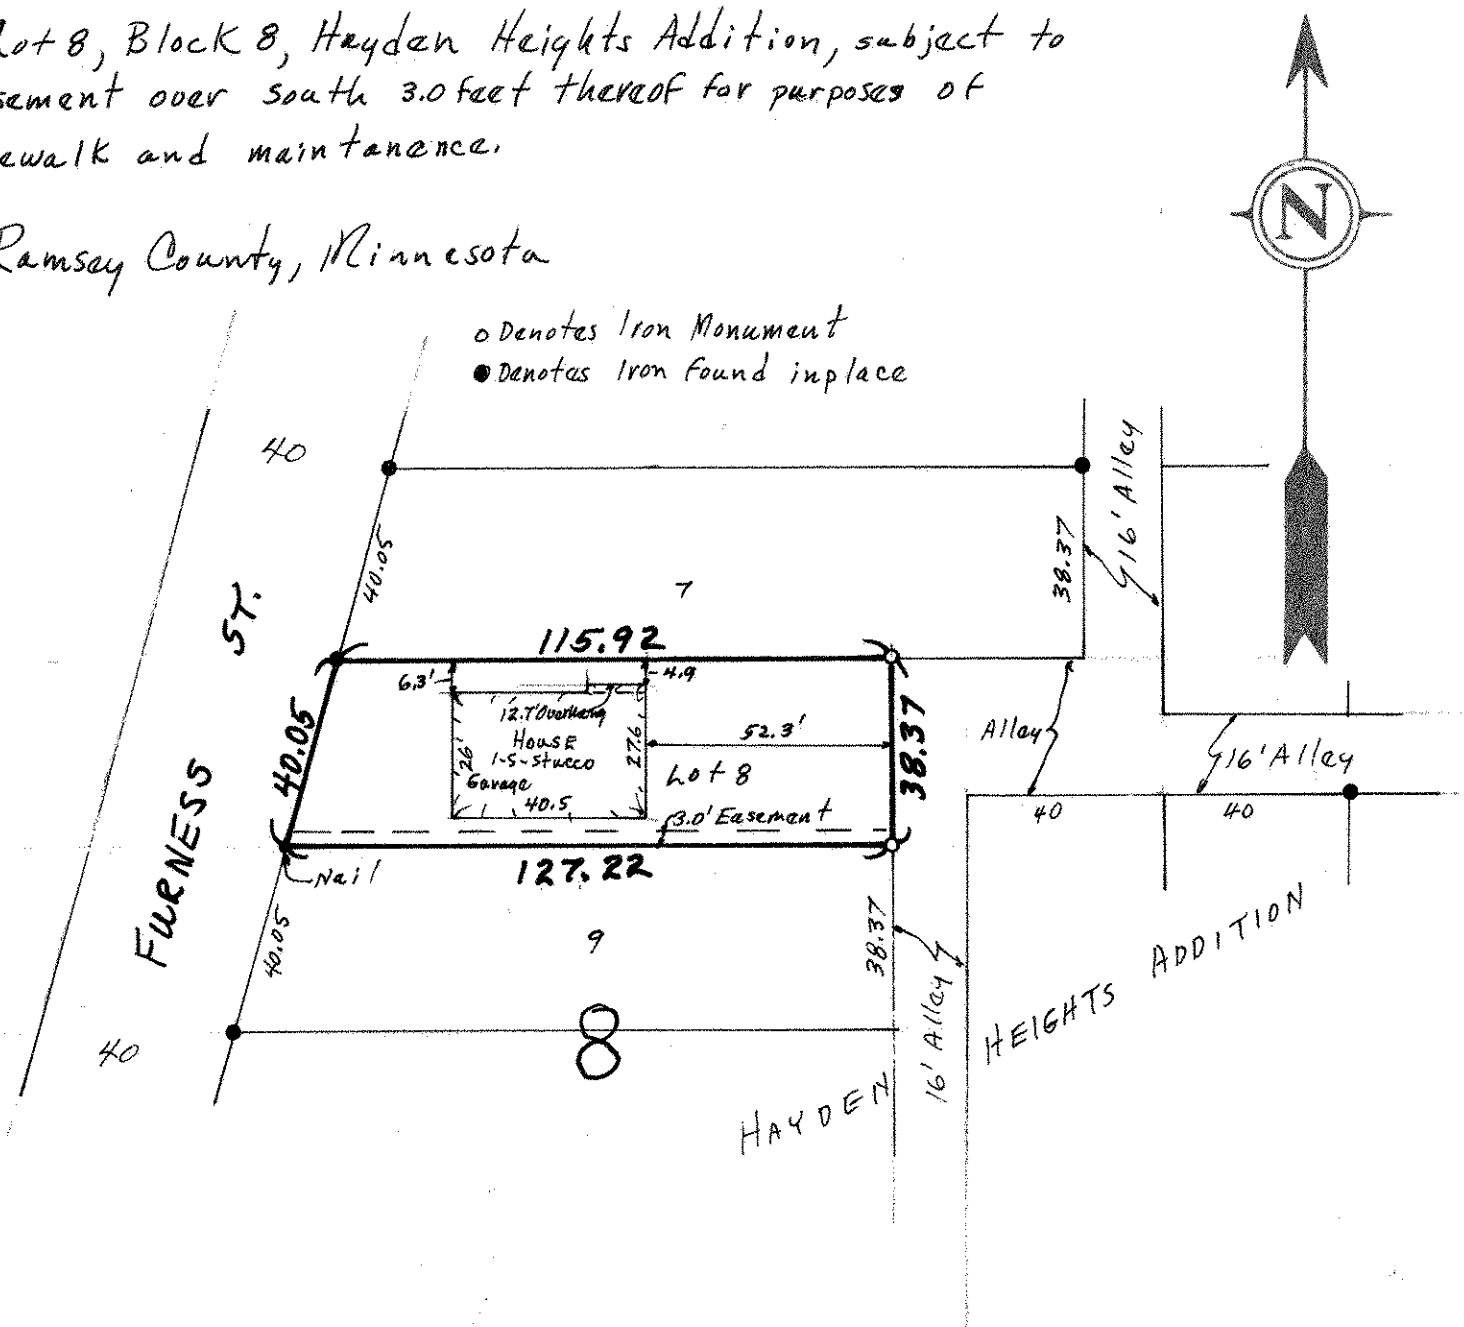
Ramsey County, Minnesota