SW 11 29 22

Certificate of Survey

From the office of

GEORGI- SCHMIDT & ASSOC. INC.

3092 No. Lexington Ave., Roseville, Mn. 55113

LAND SURVEYING

483-4408

I Hereby Certify that this plat shows a survey made by me of the property described on this plat, ~~and that the corners are correctly placed as shown,~~ and that all locations have been correctly shown.

Job Number: 573

Surveyed For Glasrud Assoc.

Date 5/1/80

Scale 1"=20'

By _____

REGISTERED LAND SURVEYOR

DESCRIPTION:
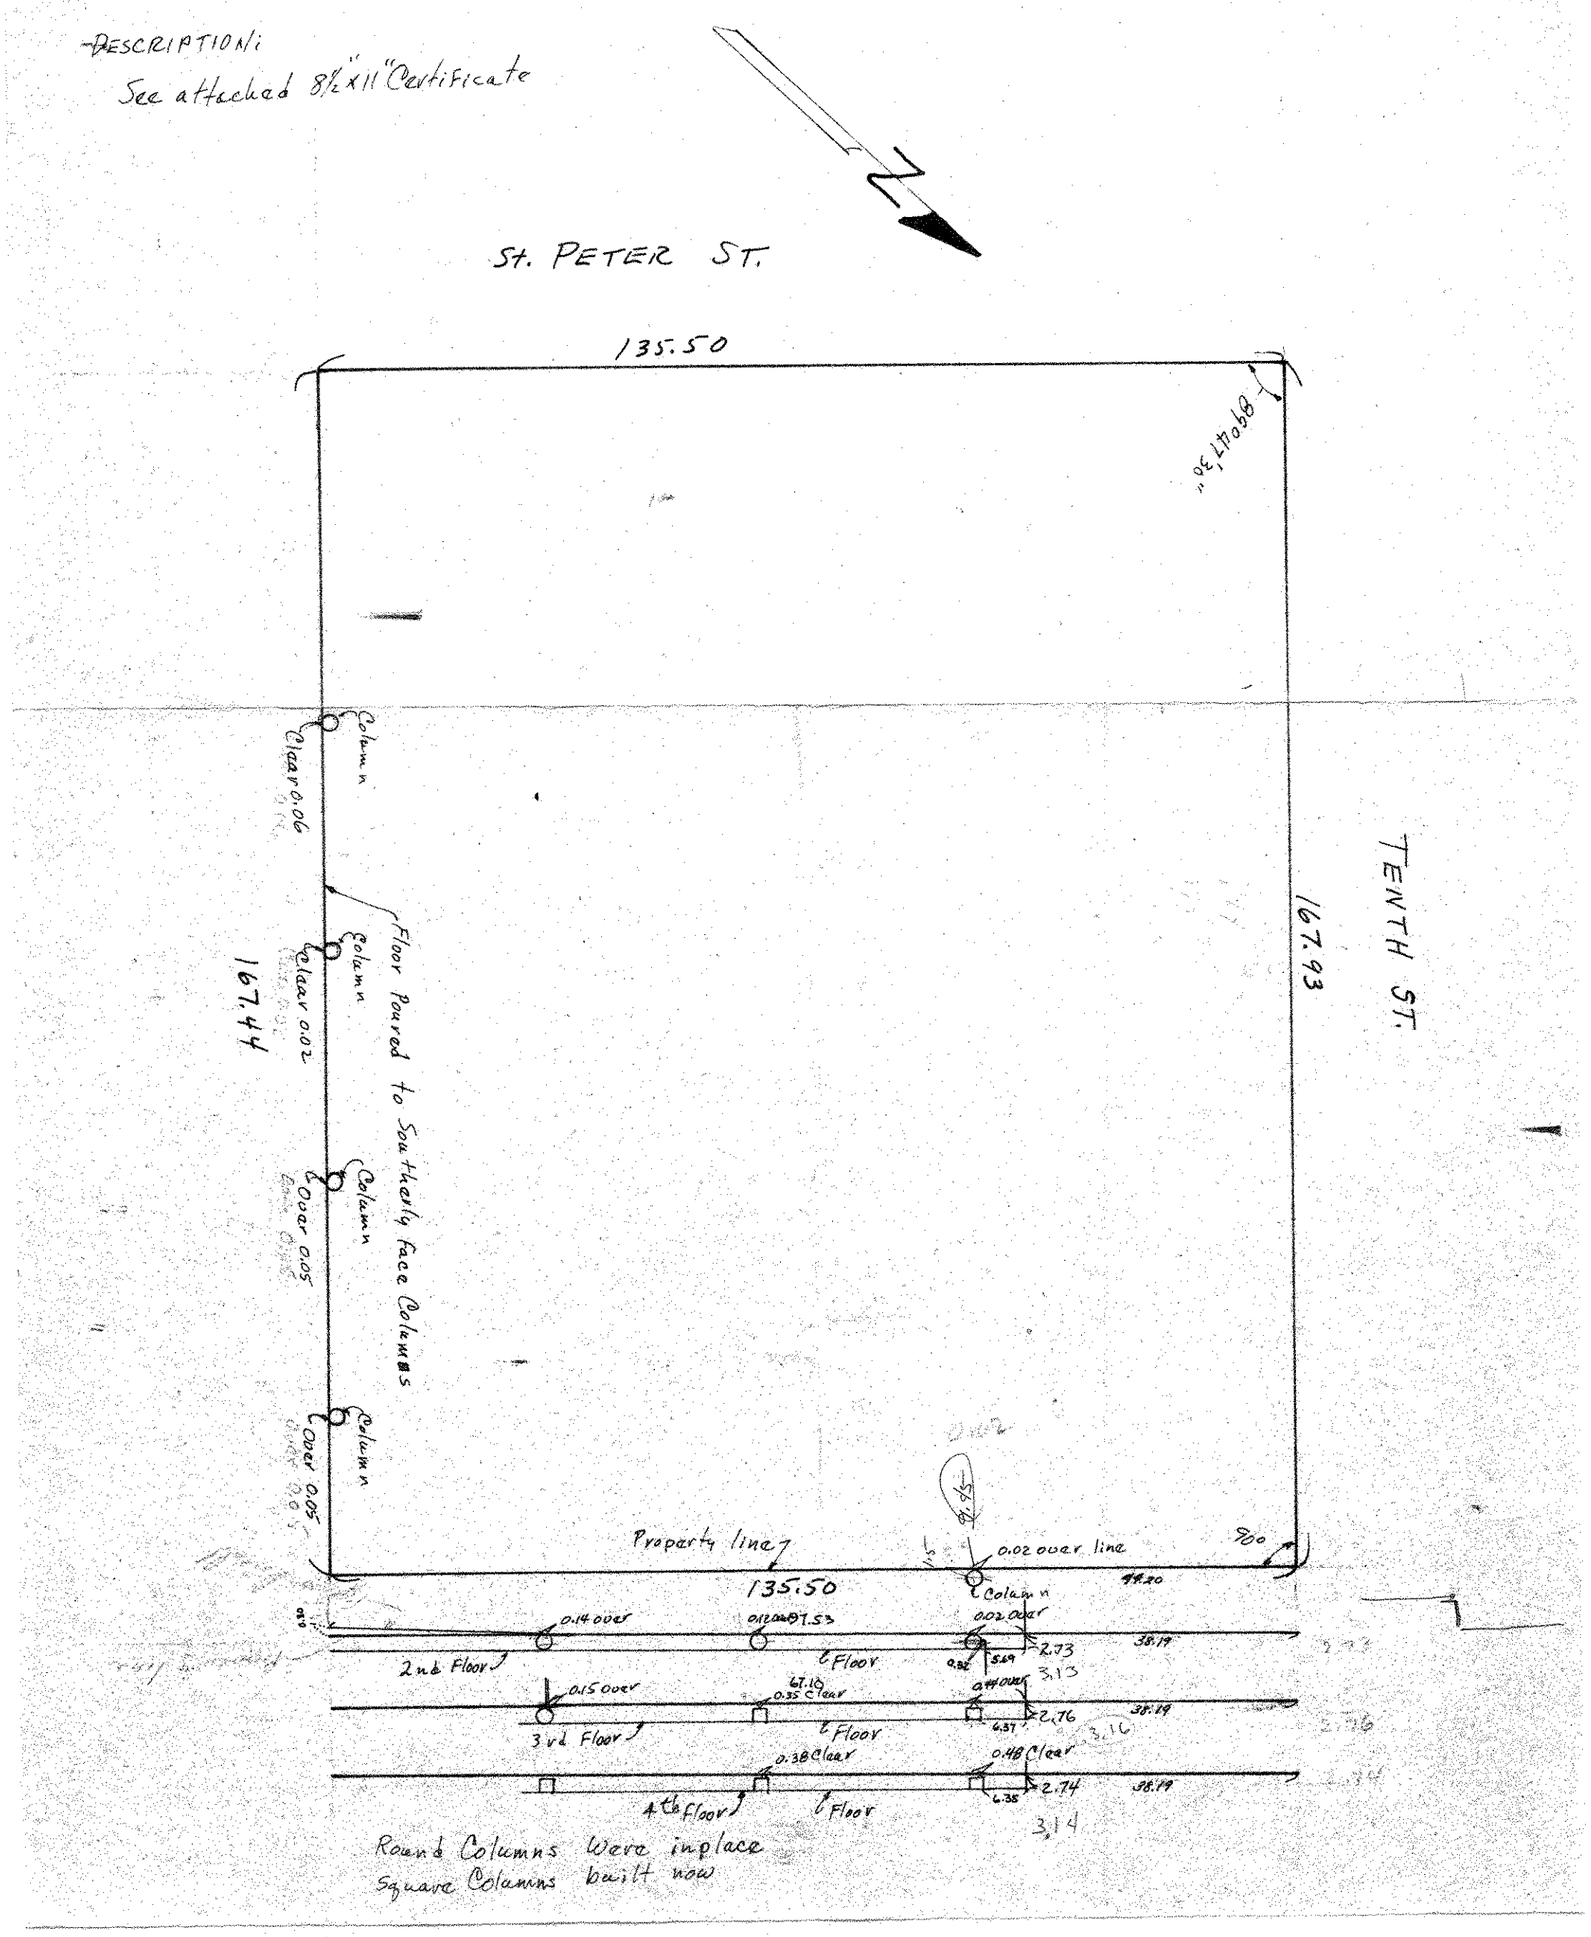
See attached 8½"x11" Certificate