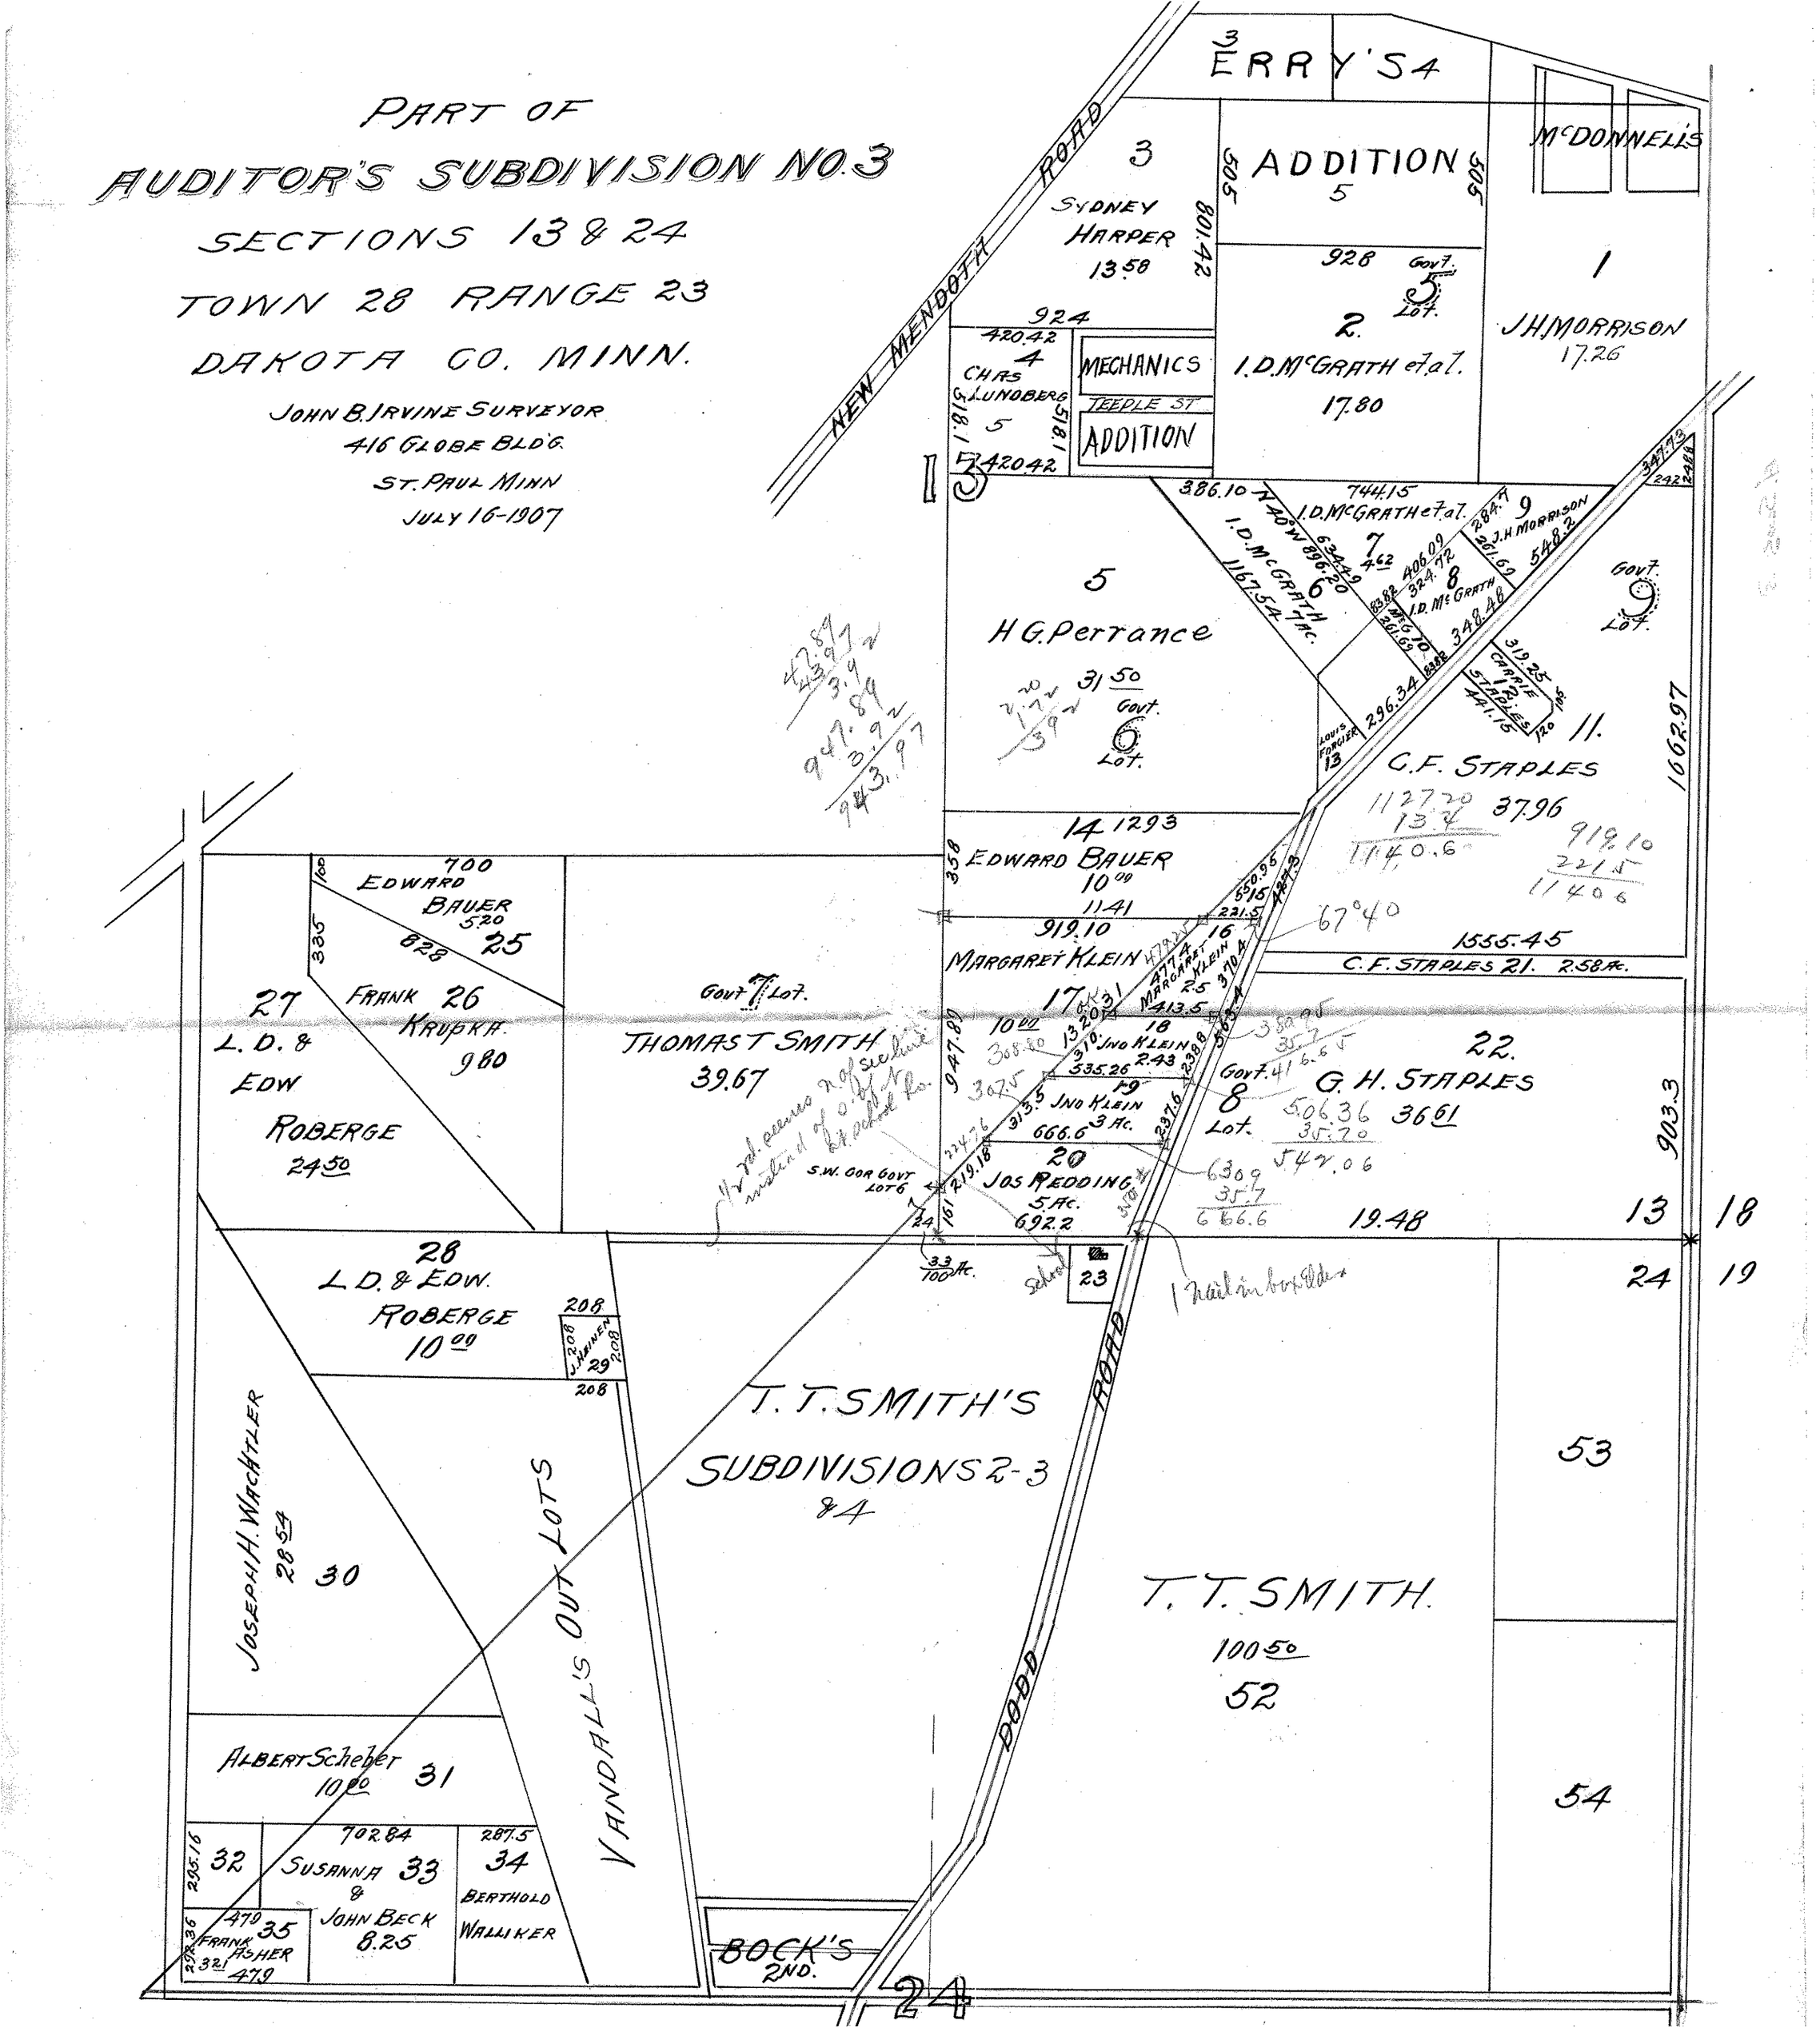
PART OF
AUDITOR'S SUBDIVISION NO. 3
SECTIONS 13 & 24
TOWN 28 RANGE 23
DAKOTA CO. MINN.
JOHN B. IRVINE SURVEYOR
416 GLOBE BLD'G.
ST. PAUL MINN
JULY 16-1907
NEW MENDOTA ROAD
ERRY'S 4
ADDITION 5
McDONNELL'S
SYDNEY HARPER 13.58
I.D. McGRATH et al. 17.80
J.H. MORRISON 17.26
CHAS LUNDBERG 5
MECHANICS
TEEPLE ST
ADDITION
I.D. McGRATH et al.
J.H. MORRISON
I.D. McGRATH
H.G. Perrance 31.50
CARRIE STAPLES
C.F. STAPLES 37.96
EDWARD BAUER 10.00
MARGARET KLEIN 17
MARGARET KLEIN
JNO KLEIN 2.43
JNO KLEIN 3 Ac.
JOS REDDING 5 Ac.
C.F. STAPLES 21. 2.58 Ac.
G.H. STAPLES 36.61
EDWARD BAUER 5.20
FRANK KRUPKA 9.80
L.D. & EDW ROBERGE 24.50
THOMAS T SMITH 39.67
S.W. COR GOVT LOT 6
L.D. & EDW. ROBERGE 10.00
J. HEINEN
T.T. SMITH'S SUBDIVISIONS 2-3 & 4
JOSEPH H. WACHTLER 28.54
VANDALL'S OUT LOTS
T.T. SMITH. 100.50
DODD ROAD
ALBERT Scheber 10.00
SUSANNA & JOHN BECK 8.25
BERTHOLD WALLIKER
FRANK ASHER
BOCK'S 2ND.
1 nail in box Elder
67°40
1662.97
903.3
1555.45
19.48
13
18
24
19
53
54
24