


LOTS 16, 17, 18, & 19
 AUDITOR'S SUBN.
 No. 3,

T. 28. R. 23.

DAKOTA CO. MINN.

SCALE 100 ft. per. inch.

□ INDICATES STAKES

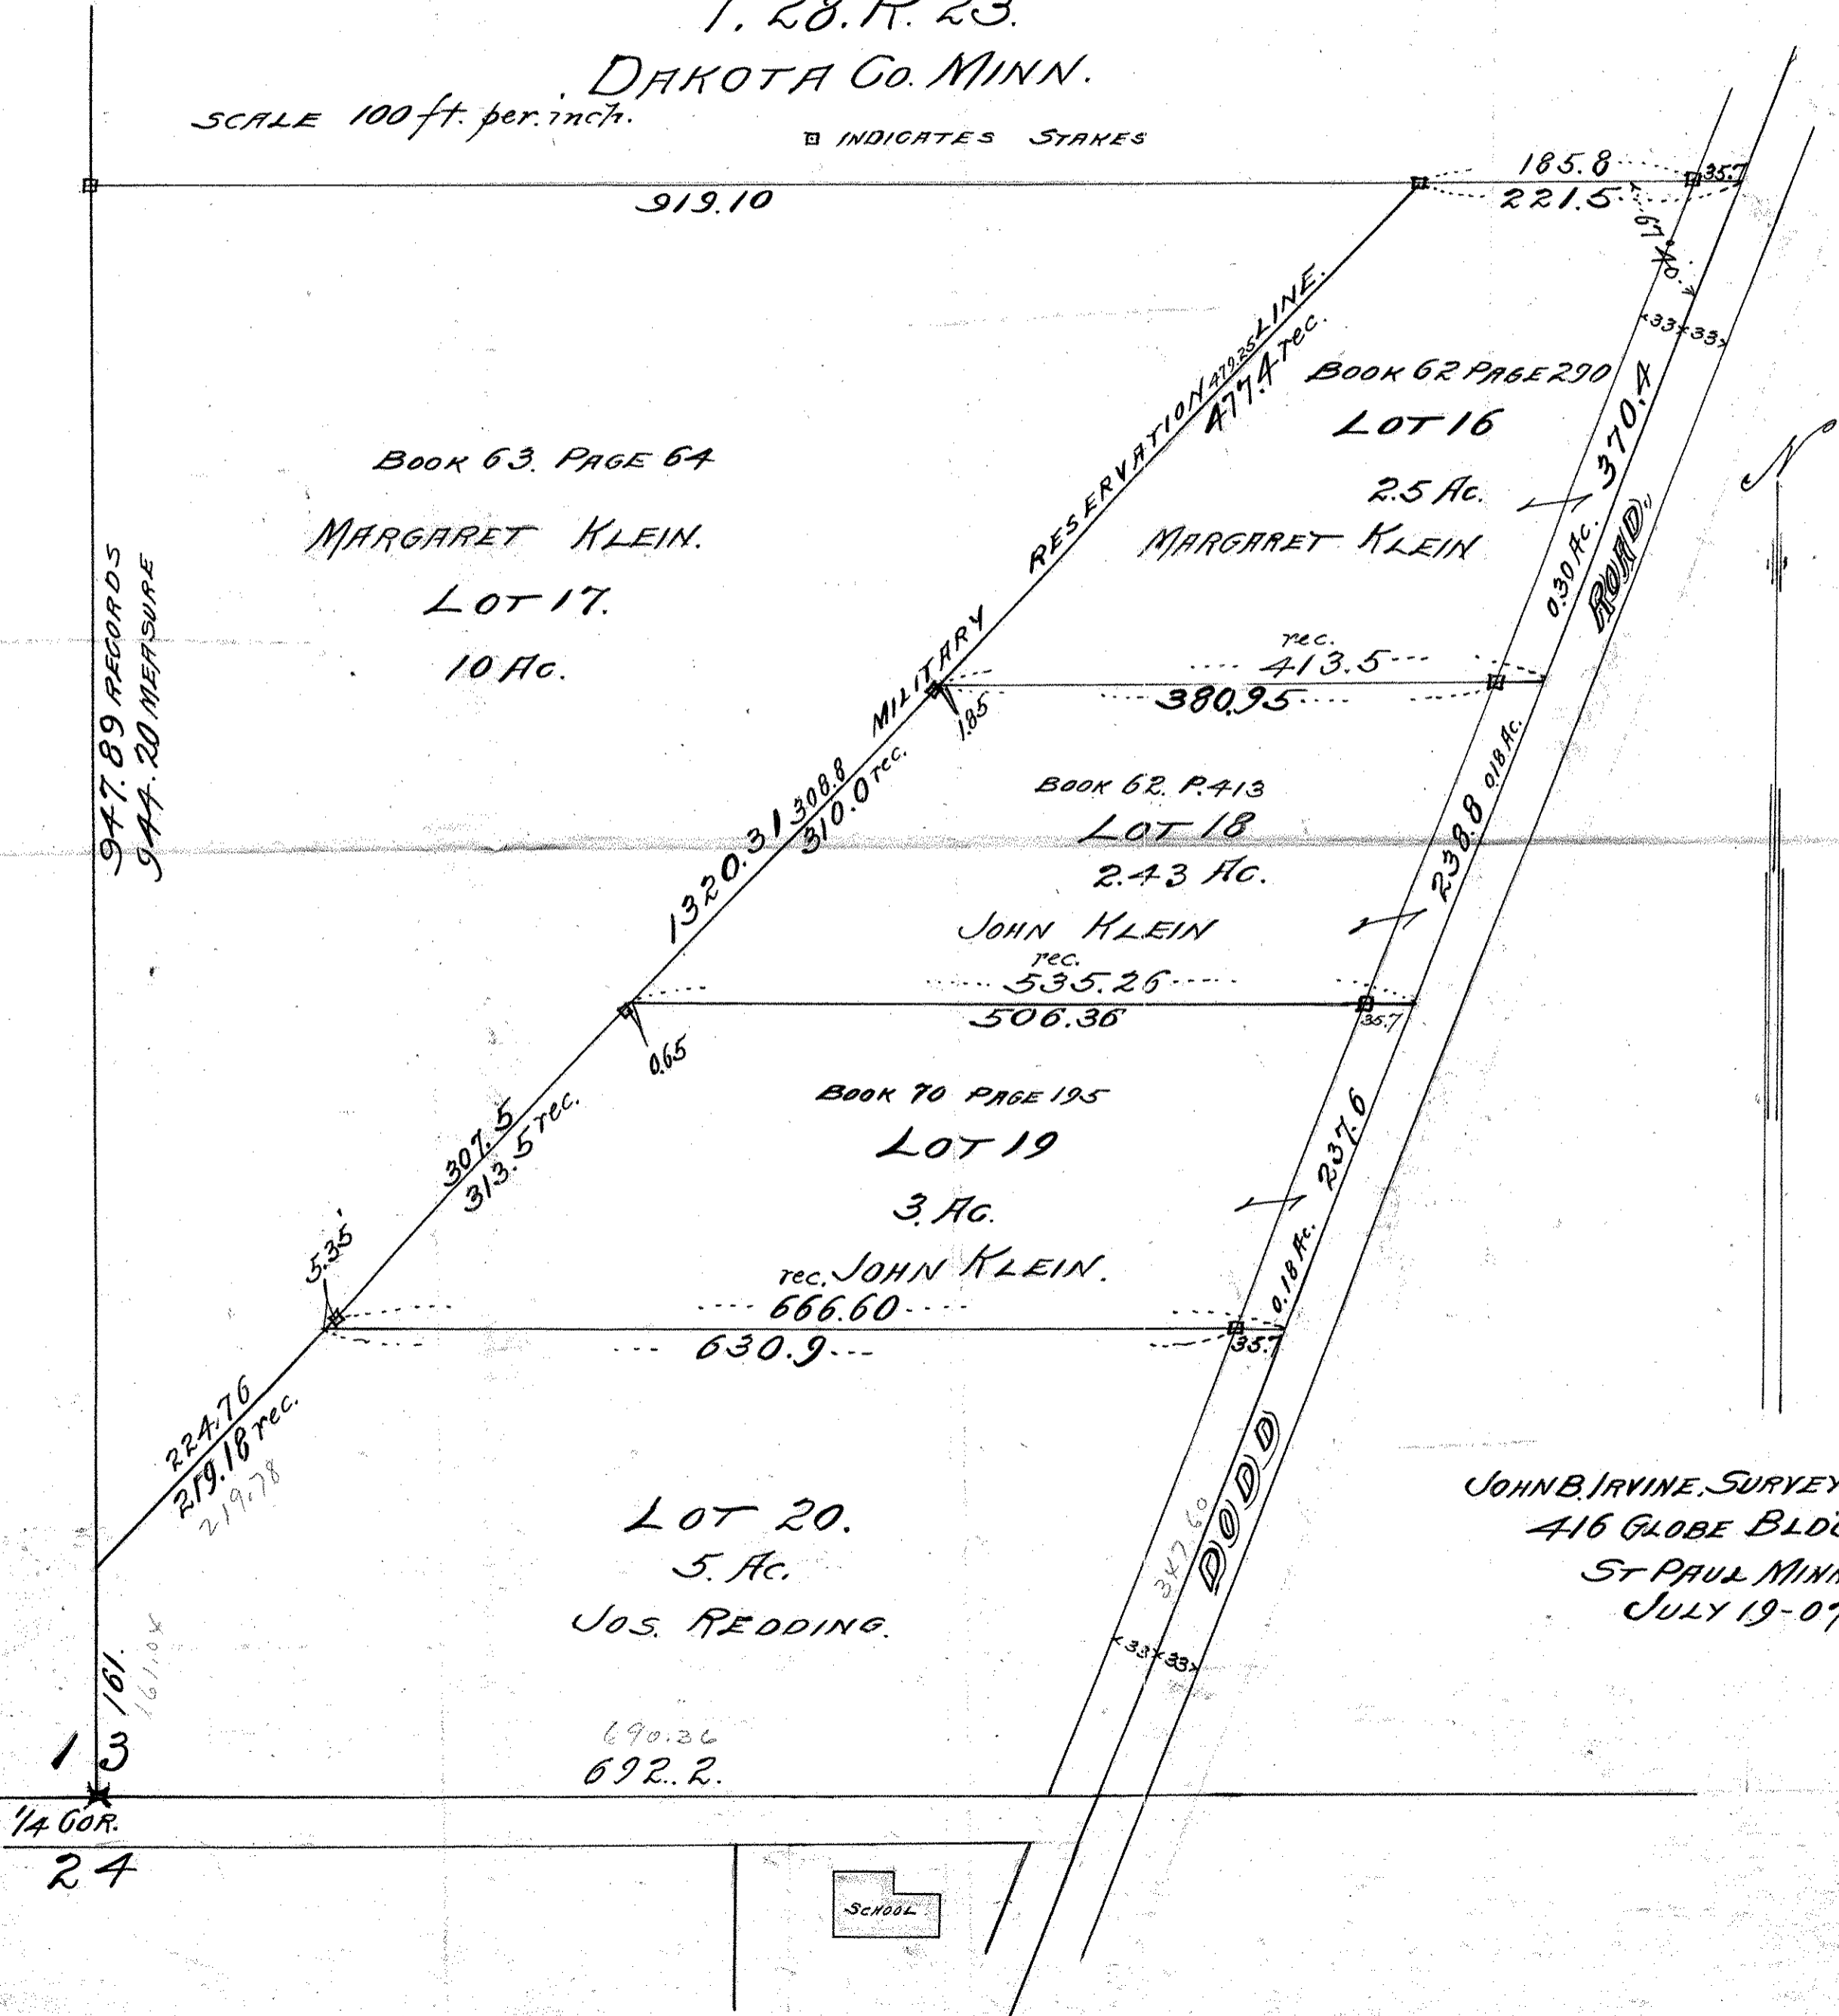

JOHN B. IRVINE, SURVEYOR.
 416 GLOBE BLDG.
 ST PAUL MINN.
 JULY 19-07.