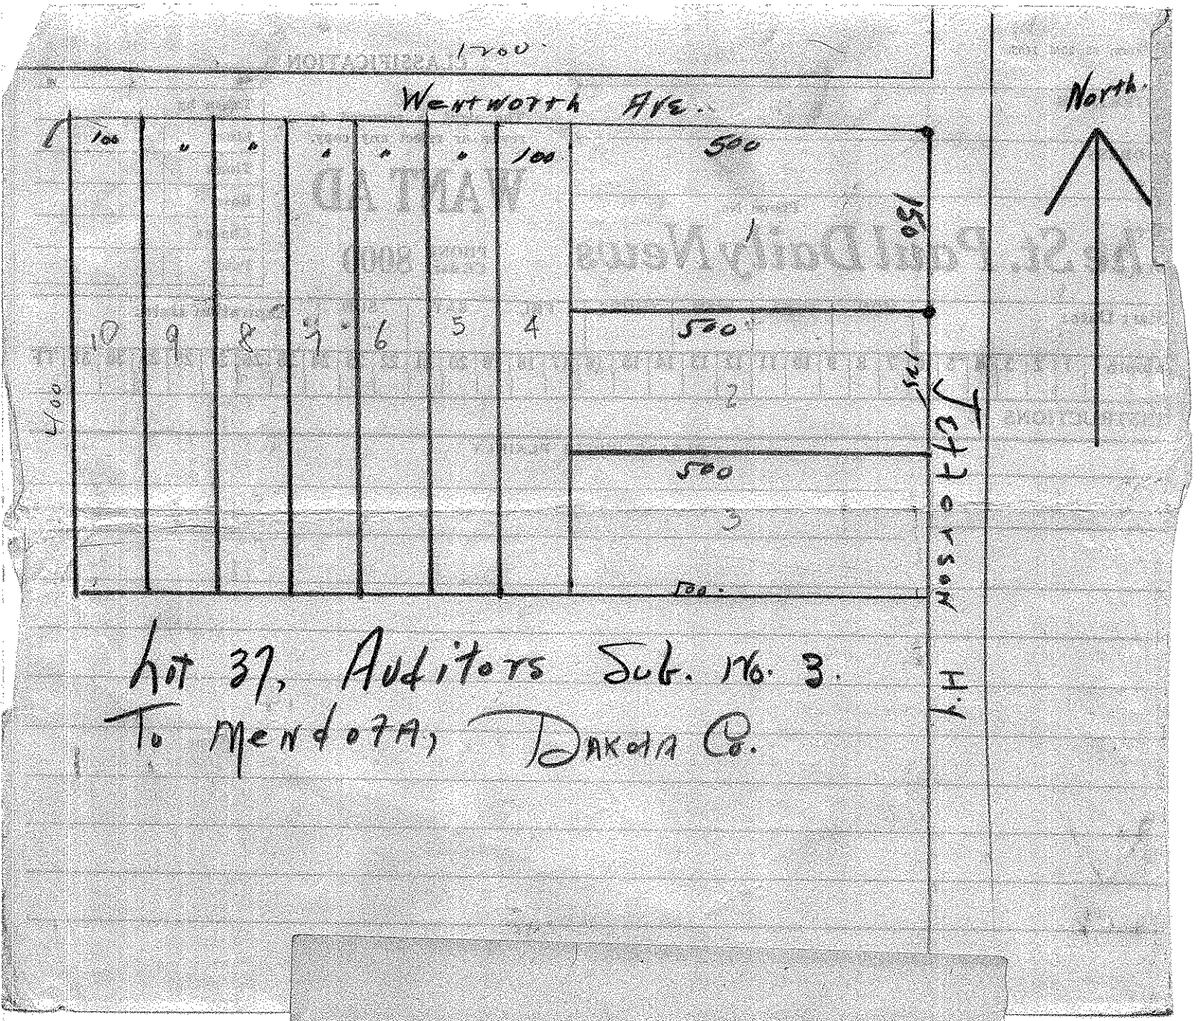
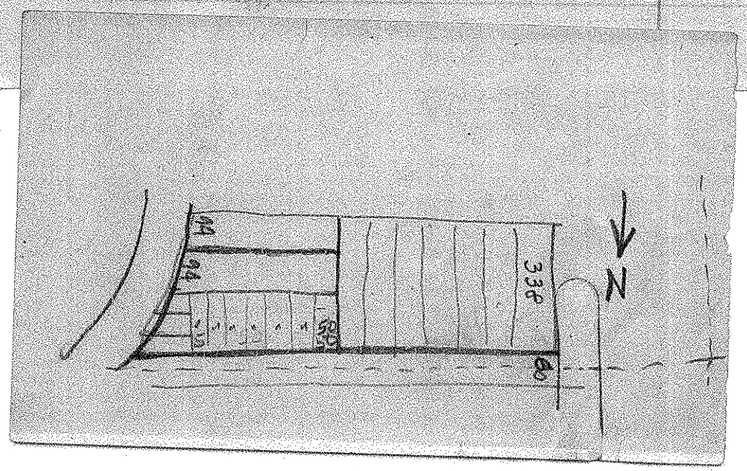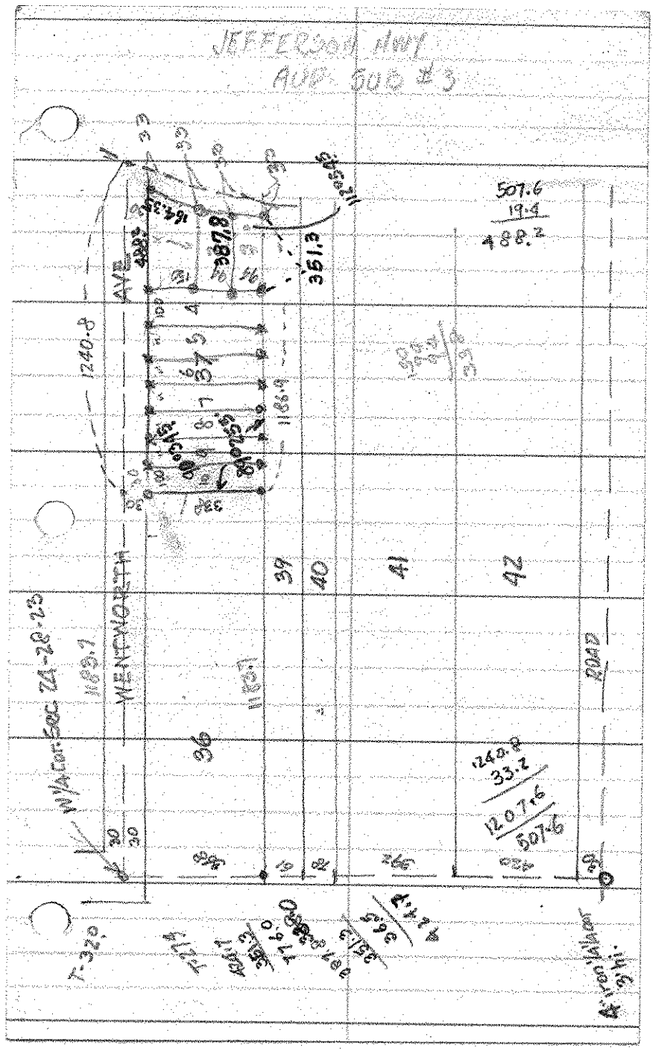
Lot 37, Auditors Sub. No. 3.
To Mendota, Dakota Co.