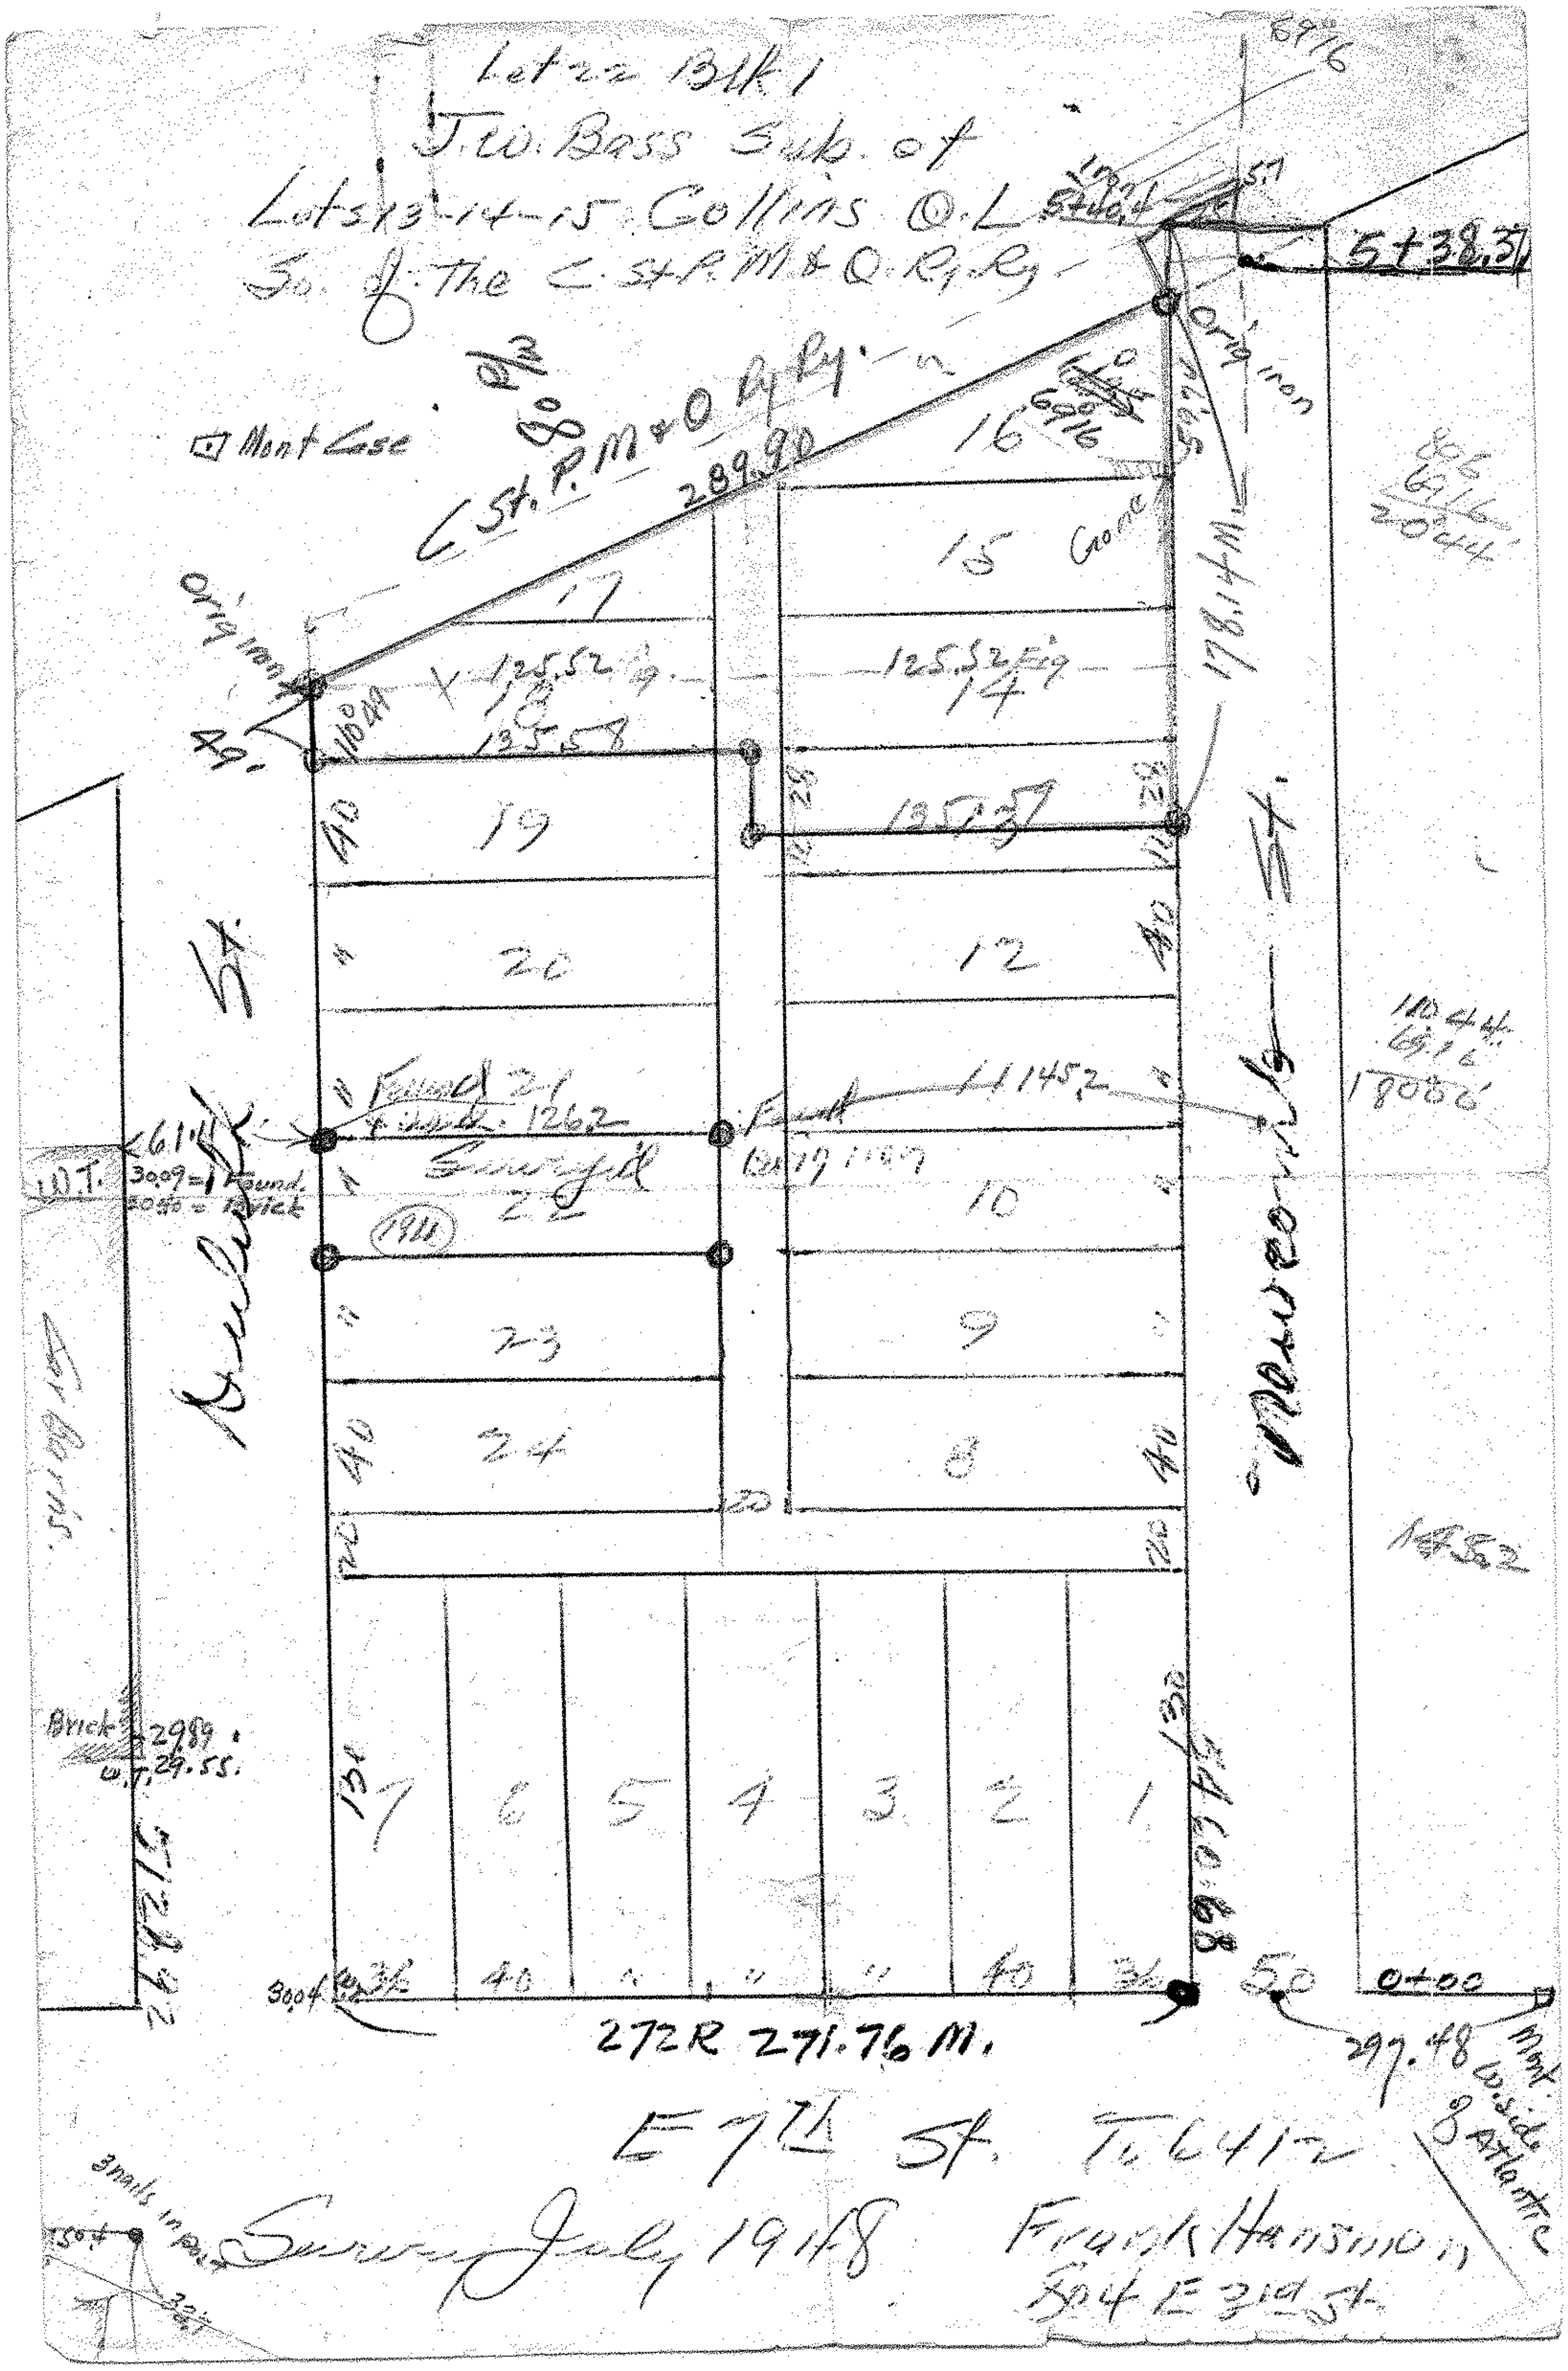
Lot 22 Blk 1
J.W. Bass Sub. of
Lots 13-14-15 Collins O.L
So. of The C. St.P.M.&O. Ry. Ry.
Mont Case
C. St. P. M & O Ry Ry.
289.90
Orig iron
5+38.37
Gone
178.14 M.
125.52
135.58
Found
1262
Surveyed
1911
11452
Brick 29.89
W.T. 29.55
3004
272R 271.76 M.
297.48
0+00
Mont. W. side of Atlantic
E 7th St.
Survey July 1918
Frank Hansmon
504 E 3rd St.