LOT 22 BLOCK. 1.
J.W. BASS' SUB'N.
LOT 15 & PART OF LOTS 13 & 14.
COLLIN'S OUT LOTS

JOHN B. IRVINE. SURVEYOR.
416 GLOBE BLD'G.
ST PAUL MINN.
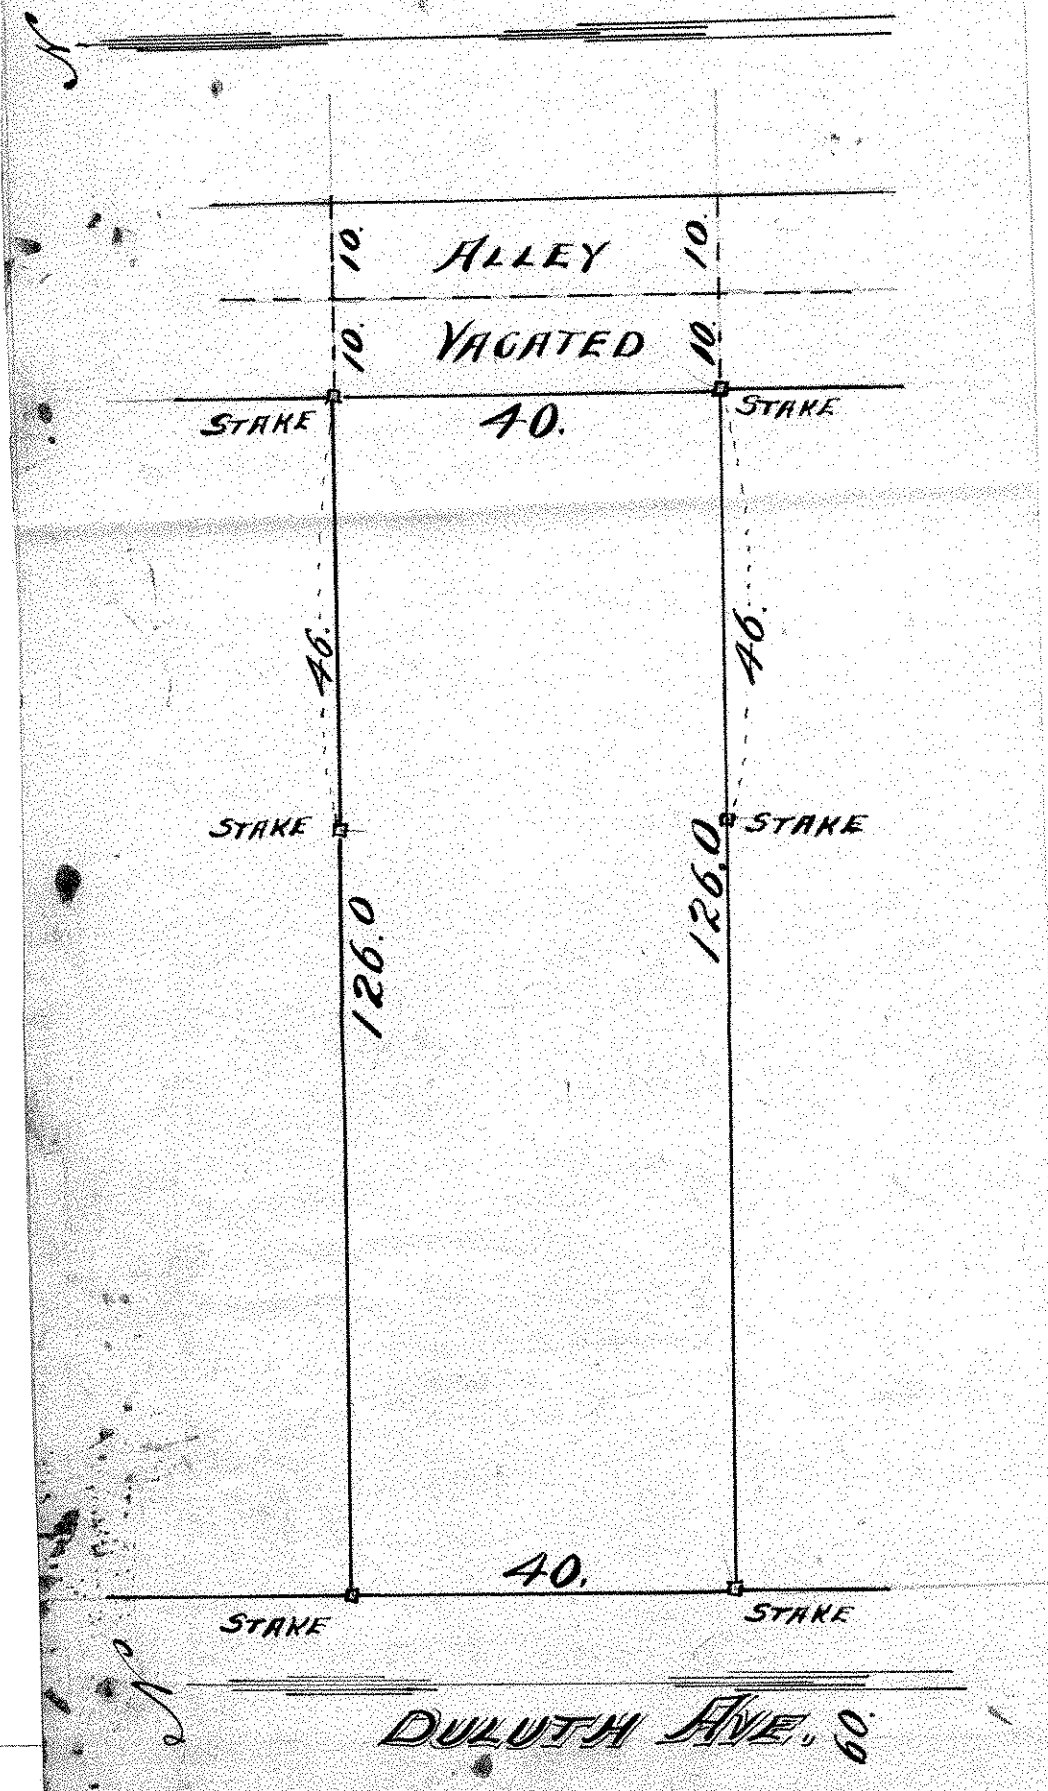
SCALE 1.IN.=20FT. SEPT. 13-1906.