

FROM THE OFFICE OF

CHARLES O. GEORGI COMPANY

2215 West County Road B

Saint Paul, Minnesota 55113

REGISTERED CIVIL ENGINEER AND LAND SURVEYOR

Certificate of Survey

I Hereby Certify that this plat shows a survey made by me of the property described on this plat, and that the corners are correctly placed as shown, and that all locations have been correctly shown.

Surveyed For Roger Heckmann

Date July 1969


Scale 1" = 30'

By Charles O. Georgi
REGISTERED LAND SURVEYOR

Description:

Lot 3,
Block 96,
Stinson's Subdivision,
Ramsey County Minn.

SE FIFTH ST.

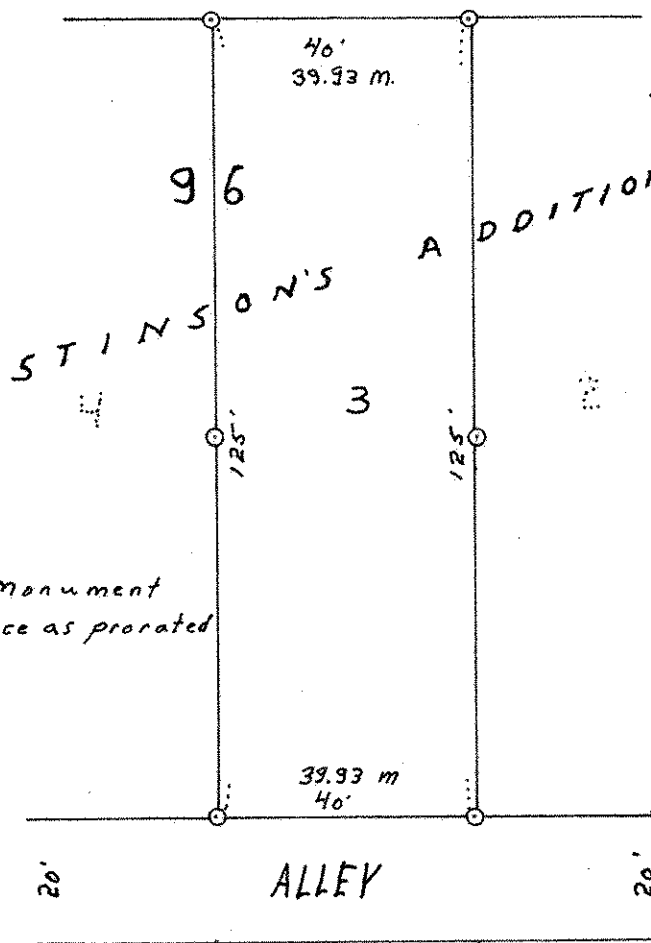

Note:
Using 60 feet for Mendota,
The shortage in lots 1 to 9
was prorated. This is in
Agreement with most walls
and fences therein.

O denotes Iron Monument
m denotes distance as prorated