

# Certificate of Survey


FROM THE OFFICE OF  
**CHARLES O. GEORGI COMPANY**  
2215 West County Road B Saint Paul, Minnesota 55113  
REGISTERED CIVIL ENGINEER AND LAND SURVEYOR

*I Heroby Certify that this plat shows a survey made by me of the property described on this plat, and that the corners are correctly placed as shown, and that all locations have been correctly shown.*

Surveyed For Michael Hawtharte  
Date December 1976  
Scale 1" = 60

By Charles O. Georgi  
REGISTERED LAND SURVEYOR

**Description:**  
Lot 12, Block 1,  
Ducharme Gervais View Park,  
Ramsey County, Minnesota

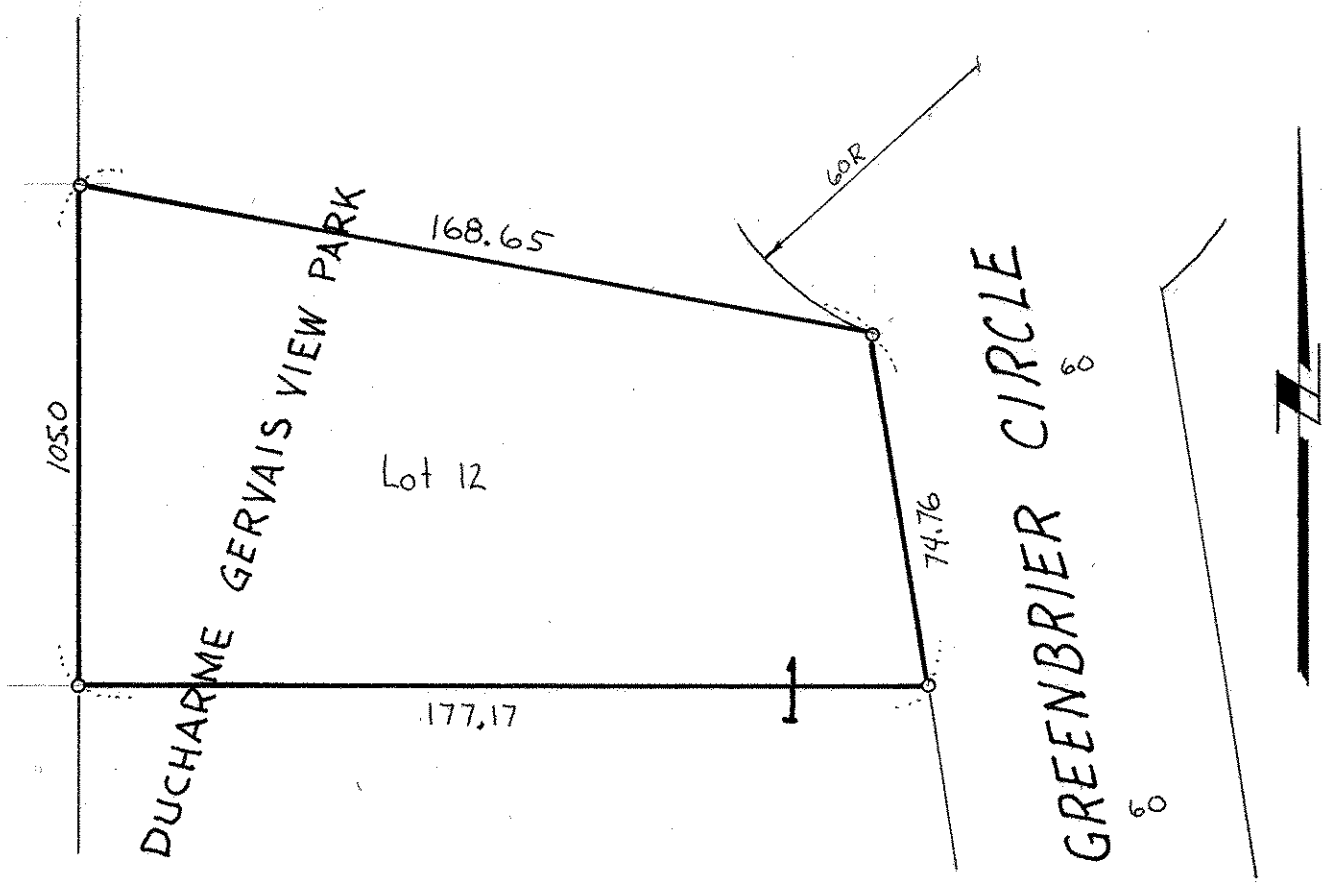

o Denotes Iron Monument  
*(all found in place)*