NW 25 29 22

FROM THE OFFICE OF

CHARLES O. GEORGI COMPANY

2215 West County Road B Saint Paul, Minnesota 55113

REGISTERED CIVIL ENGINEER AND LAND SURVEYOR

Certificate of Survey

I Hereby Certify that this plat shows a survey made by me of the property described on this plat, and that the corners are correctly placed as shown, and that all locations have been correctly shown.

Surveyed For Douglas A. Hesley

Date February 1969

Scale 1" = 50'

By Charles O. Georgi
REGISTERED LAND SURVEYOR

Description:
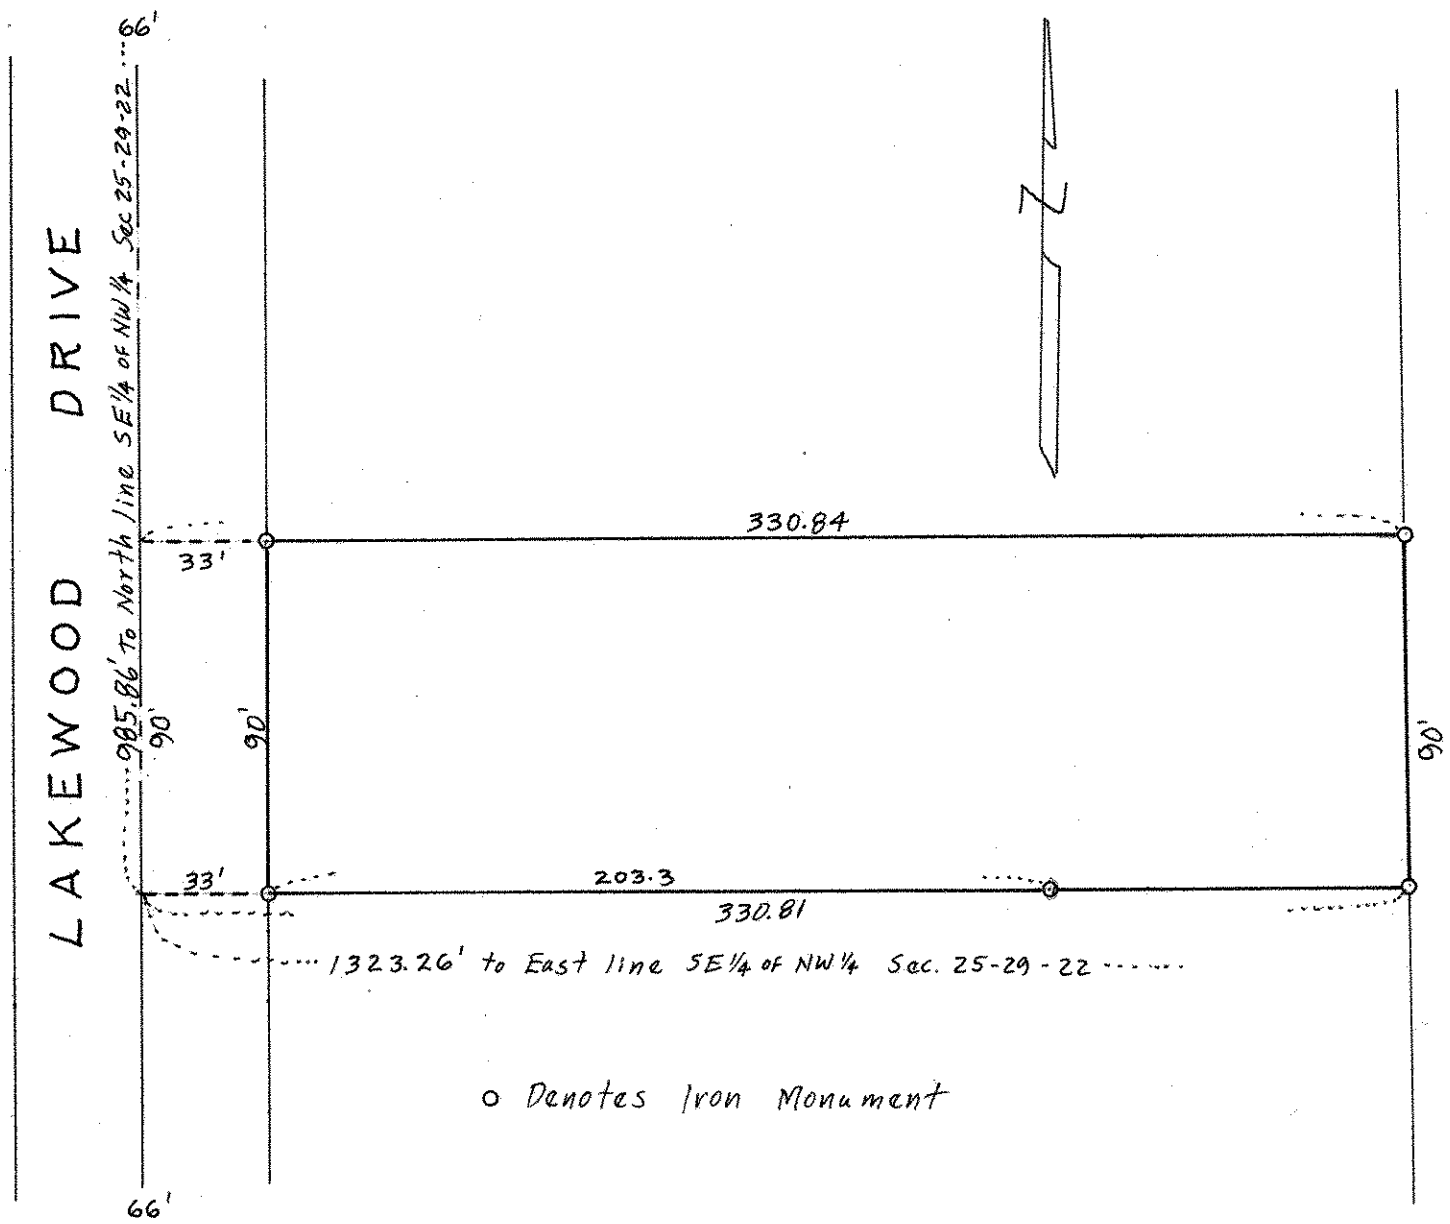
The South 90 feet of the North 985.86 feet of the West 1/4 of the SE 1/4 of NW 1/4 of Section 25, T29N, R22W. Subject to roads over the Westerly 33 feet thereof.